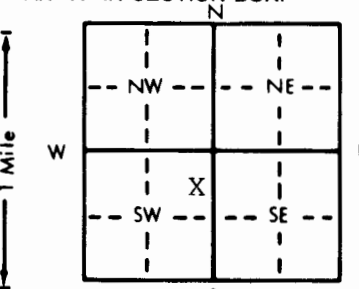


1 LOCATION OF WATER WELL: County: Stevens Fraction: ne 1/4 ne 1/4 sw 1/4 Section Number: 26 Township Number: T 32 S Range Number: R 36 EW

Distance and direction from nearest town or city street address of well if located within city?  
6 S Moscow

2 WATER WELL OWNER: RR#, St. Address, Box # : Wilber White Board of Agriculture, Division of Water Resources  
 City, State, ZIP Code : Application Number:

3 LOCATE WELL'S LOCATION WITH AN "X" IN SECTION BOX:  


4 DEPTH OF COMPLETED WELL: 495 ft. ELEVATION: Level  
 Depth(s) Groundwater Encountered 1. 260 ft. 2. ft. 3. ft.  
 WELL'S STATIC WATER LEVEL 260 ft. below land surface measured on mo/day/yr 8-15-89  
 Pump test data: Well water was ft. after hours pumping gpm  
 Est. Yield gpm: Well water was ft. after hours pumping gpm  
 Bore Hole Diameter 8 3/4 in. to 495 ft., and in. to ft.  
 WELL WATER TO BE USED AS: 5 Public water supply 8 Air conditioning 11 Injection well  
 ① Domestic 3 Feedlot 6 Oil field water supply 9 Dewatering 12 Other (Specify below)  
 2 Irrigation 4 Industrial 7 Lawn and garden only 10 Monitoring well Water Cattle  
 Was a chemical/bacteriological sample submitted to Department? Yes No x; If yes, mo/day/yr sample was submitted  
 Water Well Disinfected? Yes x No

5 TYPE OF BLANK CASING USED:  
 1 Steel 3 RMP (SR) 5 Wrought iron 8 Concrete tile CASING JOINTS: Glued x Clamped  
 2 PVC 4 ABS 6 Asbestos-Cement 9 Other (specify below) Welded  
 7 Fiberglass Threaded  
 Blank casing diameter 5 in. to 415 ft., Dia. 200 psi in. to 240 ft., Dia. in. sdr-21 ft.  
 Casing height above land surface 24 in., weight 250 PSI 240-495 lbs./ft. Wall thickness or gauge No. sdr-17  
 TYPE OF SCREEN OR PERFORATION MATERIAL:  
 1 Steel 3 Stainless steel 5 Fiberglass 8 RMP (SR) 10 Asbestos-cement 11 Other (specify)  
 2 Brass 4 Galvanized steel 6 Concrete tile 9 ABS 12 None used (open hole)  
 SCREEN OR PERFORATION OPENINGS ARE:  
 1 Continuous slot 3 Mill slot 5 Gauzed wrapped 8 Saw cut 11 None (open hole)  
 2 Louvered shutter 4 Key punched 6 Wire wrapped 9 Drilled holes  
 7 Torch cut 10 Other (specify)  
 SCREEN-PERFORATED INTERVALS: From 415 ft. to 495 ft., From ft. to ft.  
 From ft. to ft., From ft. to ft.  
 GRAVEL PACK INTERVALS: From 20 ft. to 495 ft., From ft. to ft.  
 From ft. to ft., From ft. to ft.

6 GROUT MATERIAL: 1 Neat cement 2 Cement grout 3 Bentonite 4 Other  
 Grout intervals: From 4 ft. to 20 ft., From ft. to ft., From ft. to ft.  
 What is the nearest source of possible contamination:  
 1 Septic tank 4 Lateral lines 7 Pit privy 10 Livestock pens 14 Abandoned water well  
 2 Sewer lines 5 Cess pool 8 Sewage lagoon 11 Fuel storage 15 Oil well/Gas well  
 3 Watertight sewer lines 6 Seepage pit 9 Feedyard 12 Fertilizer storage 16 Other (specify below)  
 13 Insecticide storage  
 Direction from well? N How many feet? 2000

FROM	TO	LITHOLOGIC LOG	FROM	TO	PERFORATION INTERVALS
0	268	Overburden			
268	280	Med Sand			SDR 21 ASTM 1120 200 psi 0-240
280	300	Med Sand And Clay Streaks			
300	320	" "			
320	340	" "			SDR 17 ASTM 1480 250 psi 240-495
340	360	" "			
360	380	" "			
380	400	Fine sand and Clay			
400	420	Med Sand			
420	440	" "			
440	460	" "			
460	480	" "			
480	495	" "			

7 CONTRACTOR'S OR LANDOWNER'S CERTIFICATION: This water well was (1) constructed, (2) reconstructed, or (3) plugged under my jurisdiction and was completed on (mo/day/year) 8-15-89 and this record is true to the best of my knowledge and belief. Kansas Water Well Contractor's License No. 503 This Water Well Record was completed on (mo/day/yr) 8-16-89 under the business name of C.O. Wilber White Water Well Drilling Div. C.O. by (signature) [Signature]