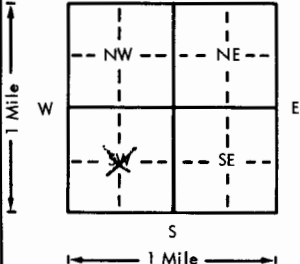


USE TYPEWRITER OR BALL POINT PEN-PRESS FIRMLY, PRINT CLEARLY.

WATER WELL RECORD  
KSA 82a-1201-1215

Kansas Department of Health and Environment-Division of Environment  
(Water well Contractors)  
Topeka, Kansas 66620

1. Location of well:		County <i>Stevens</i>	Fraction <i>Center</i> 1/4 1/4 SW 1/4	Section number <i>27</i>	Township number T <i>32</i> S	Range number R <i>36</i> E <i>27</i>
2. Distance and direction from nearest town or city: <i>5 1/2 S 1/2 W</i> Street address of well location if in city: <i>1/4 N 1/4 W of MOSCOW, Ks.</i>			3. Owner of well: <i>Carl Beallier</i> R.R. or street: <del><i>Beallier with State</i></del> City, state, zip code: <i>MOSCOW Ks. 67452</i>			
4. Locate with "X" in section below: Sketch map: 			6. Bore hole dia. <i>2 1/2</i> in. Completion date <i>2-30-76</i> Well depth: <i>560</i> ft.			
5. Type and color of material			From	To	7. <input type="checkbox"/> Cable tool <input checked="" type="checkbox"/> Rotary <input type="checkbox"/> Driven <input type="checkbox"/> Dug <input type="checkbox"/> Hollow rod <input type="checkbox"/> Jetted <input type="checkbox"/> Bored <input type="checkbox"/> Reverse rotary	
<i>Surface</i>			<i>0</i>	<i>121</i>	8. Use: <input type="checkbox"/> Domestic <input type="checkbox"/> Public supply <input type="checkbox"/> Industry <input checked="" type="checkbox"/> Irrigation <input type="checkbox"/> Air conditioning <input type="checkbox"/> Stock <input type="checkbox"/> Lawn <input type="checkbox"/> Oil field water <input type="checkbox"/> Other	
<i>F SAND with clay streaks</i>			<i>121</i>	<i>181</i>	9. Casing: Material <i>SFC</i> Height: Above or below Threaded <input type="checkbox"/> Welded <input checked="" type="checkbox"/> Surface <i>12</i> in. RMP <input type="checkbox"/> PVC <input type="checkbox"/> Weight _____ lbs./ft. Dia. <i>1 1/2</i> in. to <i>2 1/2</i> ft. depth Wall Thickness: inches or Dia. _____ in. to _____ ft. depth gage No. <i>1219</i>	
<i>F to M SAND, clay streaks</i>			<i>181</i>	<i>211</i>	10. Screen: Manufacturer's name _____ <i>LAKWOOD</i> Type <i>M.H. Slot</i> Dia. <i>1 1/2</i> Slot/gauge <i>1.25</i> Length <i>280</i> Set between <i>280</i> ft. and <i>560</i> ft. Gravel pack? <input checked="" type="checkbox"/> Size range of material <i>Fine to 1/4"</i>	
<i>M SAND &amp; gravel</i>			<i>211</i>	<i>301</i>	11. Static water level: <i>150'</i> mo./day/yr. <del><i>150'</i></del> ft. below land surface Date <i>3/24/76</i>	
<i>M SAND &amp; RED CLAY</i>			<i>301</i>	<i>361</i>	12. Pumping level below land surfaces: _____ ft. after _____ hrs. pumping _____ g.p.m. _____ ft. after _____ hrs. pumping _____ g.p.m. Estimated maximum yield _____ g.p.m.	
<i>F SAND, RED CLAY &amp; ROCK STREAKS</i>			<i>361</i>	<i>421</i>	13. Water sample submitted: _____ mo./day/yr. Yes <input checked="" type="checkbox"/> No <input type="checkbox"/> Date _____	
<i>F SAND RED CLAY STREAKS</i>			<i>421</i>	<i>451</i>	14. Well head completion: <input type="checkbox"/> Pitless adapter <i>12</i> Inches above grade	
<i>F SAND</i>			<i>451</i>	<i>481</i>	15. Well grouted? <input checked="" type="checkbox"/> With: <input type="checkbox"/> Neat cement <input checked="" type="checkbox"/> Bentonite <input type="checkbox"/> Concrete Depth: From <i>0</i> ft. to <i>10</i> ft.	
<i>F SAND RED CLAY ROCK STREAKS</i>			<i>481</i>	<i>541</i>	16. Nearest source of possible contamination: <i>NONE</i> ft. _____ Direction _____ Type _____ Well disinfected upon completion? _____ Yes <input checked="" type="checkbox"/> No <input type="checkbox"/>	
<i>F SAND CLAY to RED BED</i>			<i>541</i>	<i>560</i>	17. Pump: <input checked="" type="checkbox"/> Not installed Manufacturer's name _____ Model number _____ HP _____ Volts _____ Length of drop pipe _____ ft. capacity _____ g.p.m. Type: <input type="checkbox"/> Submersible <input type="checkbox"/> Turbine <input type="checkbox"/> Jet <input type="checkbox"/> Reciprocating <input type="checkbox"/> Centrifugal <input type="checkbox"/> Other	
(Use a second sheet if needed)						
18. Elevation:		19. Remarks: <i>Beallier bailed well &amp; poured BASE</i>			20. Water well contractor's certification: This well was drilled under my jurisdiction and this report is true to the best of my knowledge and belief. <i>Jones Drilling Co. 257</i> Business name _____ License No. _____ Address <i>Box 167 Liberal, Ks.</i> Signed <i>Mu Jones</i> _____ Date <i>3-21-76</i> Authorized representative	
Topography: <input type="checkbox"/> Hill <input checked="" type="checkbox"/> Slope <input type="checkbox"/> Upland <input type="checkbox"/> Valley						

S 2 36 E 27 CSW