


1 LOCATION OF WATER WELL: Fraction SW 4 SW 4 NE 1 Section Number 25 Township Number T 32 S Range Number R 37 EW
 County Stevens

Distance and direction from nearest town or city street address of well if located within city?
3.5 miles NE of Hugoton on Hwy 56 - 1/2 mile East

2 WATER WELL OWNER: Gregory Bond
 RR# St. Address, Box # P.O. Box B Board of Agriculture, Division of Water Resources
 City, State, ZIP Code Hugoton, Kansas 67951 Application Number

3 LOCATE WELL'S LOCATION WITH AN 'X' IN SECTION BOX:

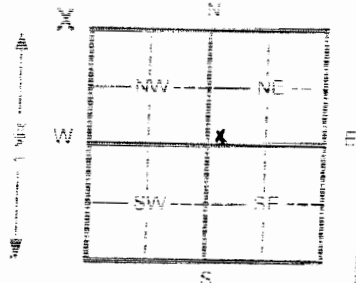

4 DEPTH OF COMPLETED WELL 170 ft. ELEVATION
 Depth(s) Groundwater Encountered 1 155 ft. 2 _____ ft. 3 _____ ft.
 WELL'S STATIC WATER LEVEL 155 ft. below land surface measured on (mo/day/yr) 11-30-05
 Pump test data: Well water was _____ ft. after _____ hours pumping _____ gpm
 Est. Yield _____ gpm; Well water was _____ ft. after _____ hours pumping _____ gpm
 Bore Hole Diameter _____ in. to _____ ft. and _____ in. to _____ ft.
 WELL WATER TO BE USED AS: 5 Public water supply 8 Air conditioning 11 Injection well
 1 Domestic 3 Feed lot 6 Oil field water supply 9 Dewatering 12 Other (Specify below)
 2 Irrigation 4 Industrial 7 Lawn and garden (domestic) 10 Monitoring well Livestock
 Was a chemical/bacteriological sample submitted to Department? Yes _____ No _____ If yes, (mo/day/yr) sample was submitted _____
 Water Well Disinfected? Yes No _____

5 TYPE OF BLANK CASING USED:
 1 Steel 2 RMP (SR) 3 Wrought iron 4 Concrete tile CASING JOINTS: Glued _____ Clamped _____
 5 PVC 6 ABS 7 Fiberglass 8 Other (specify below) Welded _____ Threaded _____

Blank casing diameter 7 in. to _____ ft. Dia _____ in. to _____ ft. Dia _____ in. to _____ ft.
 Casing height above land surface _____ in. weight _____ lbs./ft. Wall thickness or gauge No. _____

TYPE OF SCREEN OR PERFORATION MATERIAL:
 1 Steel 2 Brass 3 Stainless steel 4 Galvanized steel 5 Fiberglass 6 Concrete tile 7 PVC 8 RMP (SR) 9 ABS 10 Asbestos-cement 11 Other (specify) 12 None used (open hole)

SCREEN OR PERFORATION OPENINGS ARE:
 1 Continuous slot 2 Mill slot 3 Gaufr wrapped 4 Wire wrapped 5 Saw cut 6 Drilled holes 7 Louvered shutter 8 Key punched 9 Torch cut 10 Other (specify)

SCREEN PERFORATED INTERVALS: From _____ ft. to _____ ft. From _____ ft. to _____ ft.
 GRAVEL PACK INTERVALS: From _____ ft. to _____ ft. From _____ ft. to _____ ft.

6 GROUT MATERIAL: 1 Neat cement 2 Cement grout 3 Bentonite 4 Other
 Grout intervals: From _____ ft. to _____ ft. From _____ ft. to _____ ft. From _____ ft. to _____ ft.

What is the nearest source of possible contamination:
 1 Septic tank 2 Sewer lines 3 Watertight sewer lines 4 Lateral lines 5 Cess pool 6 Seepage pit 7 Pit privy 8 Sewage lagoon 9 Feedyard 10 Livestock pens 11 Fuel storage 12 Fertilizer storage 13 Insecticide storage 14 Abandoned water well 15 Oil well/ Gas well 16 Other (specify below)
 Direction from well? SE How many feet? 700

FROM	TO	CODE	LITHOLOGIC LOG	FROM	TO	PLUGGING INTERVALS
				170	135	Gravel Fill
				135	125	Bentonite Plug
				125	15	Fill
				15	3	Cement Plug

7 CONTRACTOR'S OR LANDOWNER'S CERTIFICATION: This water well was (1) constructed, (2) reconstructed, or (3) plugged under my jurisdiction and was completed on (mo/day/yr) 11-30-05 and this record is true to the best of my knowledge and belief. Kansas
 Water Well Contractor's License No. 4773 This Water Well Record was completed on (mo/day/yr) 12-1-05
 under the business name of Tyler Water Well Serv by (signature) Paul G. G...

INSTRUCTIONS: Please fill in blanks and circle the correct answers. Send three copies to Kansas Department of Health and Environment, Bureau of Water, Topeka, Kansas 66620-0001 Telephone: 913-296-5545. Send one to WATER WELL OWNER and retain one for your records.

OFFICE USE ONLY

SEC