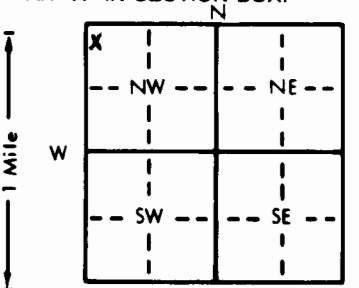


1 LOCATION OF WATER WELL: County: **Stevens** Fraction: **NW 1/4 NW 1/4 NW 1/4** Section Number: **10** Township Number: **T 32 S** Range Number: **R 37W EW**

Distance and direction from nearest town or city street address of well if located within city? **Hugoton, Kansas - 6 1/2 miles North East into location.**


2 WATER WELL OWNER: **F.E. Gillespie**
 RR#, St. Address, Box # :
 City, State, ZIP Code : **Hugoton, KS 67951**
 Board of Agriculture, Division of Water Resources
 Application Number:

3 LOCATE WELL'S LOCATION WITH AN "X" IN SECTION BOX:

 4 DEPTH OF COMPLETED WELL: **320'** ft. ELEVATION:
 Depth(s) Groundwater Encountered 1. **160'** ft. 2. ft. 3. ft.
 WELL'S STATIC WATER LEVEL **160'** ft. below land surface measured on mo/day/yr **08/13/88**
 Pump test data: Well water was ft. after hours pumping gpm
 Est. Yield gpm: Well water was ft. after hours pumping gpm
 Bore Hole Diameter: **9** in. to **320'** ft., and in. to ft.
 WELL WATER TO BE USED AS:
 1 Domestic 3 Feedlot 6 Oil field water supply 9 Dewatering 12 Other (Specify below)
 2 Irrigation 4 Industrial 7 Lawn and garden only 10 Observation well
 Was a chemical/bacteriological sample submitted to Department? Yes No X; If yes, mo/day/yr sample was submitted
 Water Well Disinfected? Yes X No

5 TYPE OF BLANK CASING USED:
 1 Steel 3 RMP (SR) 5 Wrought iron 8 Concrete tile CASING JOINTS: Glued Clamped
 2 PVC 4 ABS 6 Asbestos-Cement 9 Other (specify below) Welded
 7 Fiberglass Threaded
 Blank casing diameter **5.563** in. to **220'** ft., Dia in. to ft., Dia in. to ft.
 Casing height above land surface **28** in., weight **2.93** lbs./ft. Wall thickness or gauge No. **.265**
 TYPE OF SCREEN OR PERFORATION MATERIAL:
 1 Steel 3 Stainless steel 5 Fiberglass 7 PVC 10 Asbestos-cement
 2 Brass 4 Galvanized steel 6 Concrete tile 8 RMP (SR) 11 Other (specify)
 9 ABS 12 None used (open hole)
 SCREEN OR PERFORATION OPENINGS ARE:
 1 Continuous slot 3 Mill slot 5 Gauzed wrapped 8 Saw cut 11 None (open hole)
 2 Louvered shutter 4 Key punched 6 Wire wrapped 9 Drilled holes
 7 Torch cut 10 Other (specify)
 SCREEN-PERFORATED INTERVALS: From **140** ft. to **160** ft., From **220** ft. to **280** ft.
 From **300** ft. to **320** ft., From ft. to ft.
 GRAVEL PACK INTERVALS: From **27** ft. to **50** ft., From **60** ft. to **320** ft.
 From ft. to ft., From ft. to ft.

6 GROUT MATERIAL: 1 Neat cement 2 Cement grout 3 Bentonite 4 Other
 Grout Intervals: From **5** ft. to **7** ft., From **7** ft. to **27** ft., From **50** ft. to **60** ft.
 What is the nearest source of possible contamination:
 1 Septic tank 4 Lateral lines 7 Pit privy 10 Livestock pens 14 Abandoned water well
 2 Sewer lines 5 Cess pool 8 Sewage lagoon 11 Fuel storage 15 Oil well/Gas well
 3 Watertight sewer lines 6 Seepage pit 9 Feedyard 12 Fertilizer storage 16 Other (specify below)
 13 Insecticide storage
 Direction from well? **South** How many feet? **175'**

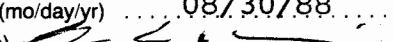FROM	TO	LITHOLOGIC LOG	FROM	TO	LITHOLOGIC LOG
0	2	Surface			
2	31	Sandy Clay			
31	42	Med. to large sand			
42	65	Sandy Clay - Caliche			
65	89	Fine Sand			
89	125	5% Clay - 95% Med. to large sand			
125	196	Sandy Clay			
196	220	Med. to large sand			
220	238	10% Clay - 90% Fine Sand			
238	260	Med. to large sand			
260	320	Sandy Clay			

7 CONTRACTOR'S OR LANDOWNER'S CERTIFICATION: This water well (1) constructed, (2) reconstructed, or (3) plugged under my jurisdiction and was completed on (mo/day/year) **08/13/88** and this record is true to the best of my knowledge and belief. Kansas Water Well Contractor's License No. **118** This Water Well Record was completed on (mo/day/yr) **08/30/88** under the business name of **Carlile Water Well Service, Inc.** by (signature) 

INSTRUCTIONS: Use typewriter or ball point pen. PLEASE PRESS FIRMLY and PRINT clearly. Please fill in blanks. underline or circle the correct answers. Send top three copies to Kansas Department of Health and Environment, Bureau of Water Protection, Topeka, Kansas 66620-7320, Telephone: 913-862-9360. Send one to WATER WELL OWNER and retain one for your records.

OFFICE USE ONLY
T
R
EW
SEC.