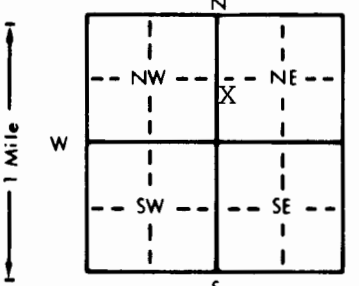


1 LOCATION OF WATER WELL: Fraction NW 1/4 SW 1/4 NE 1/4 Section Number 15 Township Number T 32 S Range Number R 37 ~~E/W~~  
 County: STEVENS

Distance and direction from nearest town or city street address of well if located within city?  
 6 1/2 MILES NORTH AND 1/2 MILE EAST OF HUGOTON, KANSAS.

2 WATER WELL OWNER: JOHN R. ELLIS ESTATE TRUST  
 RR#, St. Address, Box # : 1205 PERRY Board of Agriculture, Division of Water Resources  
 City, State, ZIP Code : WICHITA, KS 67203 Application Number: 3961

3 LOCATE WELL'S LOCATION WITH AN "X" IN SECTION BOX:  
  
 4 DEPTH OF COMPLETED WELL: 360 ft. ELEVATION:  
 Depth(s) Groundwater Encountered 1. ft. 2. ft. 3. ft.  
 WELL'S STATIC WATER LEVEL 188 ft. below land surface measured on mo/day/yr 6/14/93  
 Pump test data: Well water was ft. after hours pumping gpm  
 Est. Yield gpm: Well water was ft. after hours pumping gpm  
 Bore Hole Diameter 26 in. to 360 ft., and in. to ft.  
 WELL WATER TO BE USED AS:  
 1 Domestic 3 Feedlot 6 Oil field water supply 9 Dewatering 12 Other (Specify below)  
 2 Irrigation 4 Industrial 7 Lawn and garden only 10 Monitoring well  
 Was a chemical/bacteriological sample submitted to Department? Yes No X; If yes, mo/day/yr sample was submitted  
 Water Well Disinfected? Yes No

5 TYPE OF BLANK CASING USED:  
 1 Steel 3 RMP (SR) 5 Wrought iron 8 Concrete tile CASING JOINTS: Glued Clamped  
 2 PVC 4 ABS 6 Asbestos-Cement 9 Other (specify below) Welded X  
 7 Fiberglass Threaded  
 Blank casing diameter 16 in. to 360 ft., Dia in. to ft., Dia in. to ft.  
 Casing height above land surface 12 in., weight 42.5 lbs./ft. Wall thickness or gauge No. 250  
 TYPE OF SCREEN OR PERFORATION MATERIAL:  
 1 Steel 3 Stainless steel 5 Fiberglass 7 PVC 10 Asbestos-cement  
 2 Brass 4 Galvanized steel 6 Concrete tile 8 RMP (SR) 11 Other (specify)  
 9 ABS 12 None used (open hole)  
 SCREEN OR PERFORATION OPENINGS ARE:  
 1 Continuous slot 3 Mill slot 5 Gauzed wrapped 8 Saw cut 11 None (open hole)  
 2 Louvered shutter 4 Key punched 6 Wire wrapped 9 Drilled holes  
 7 Torch cut 10 Other (specify)  
 SCREEN-PERFORATED INTERVALS: From PERF. 210 ft. to 272 ft., From SCREEN 272 ft. to 312 ft.  
 From PERF. 312 ft. to 323 ft., From SCREEN 323 ft. to 343 ft.  
 GRAVEL PACK INTERVALS: From 20 ft. to 360 ft., From PERF. 343 ft. to 360 ft.

6 GROUT MATERIAL: 1 Neat cement 2 Cement grout 3 Bentonite 4 Other  
 Grout Intervals: From 0 ft. to 20 ft., From ft. to ft., From ft. to ft.  
 What is the nearest source of possible contamination:  
 1 Septic tank 4 Lateral lines 7 Pit privy 10 Livestock pens 14 Abandoned water well  
 2 Sewer lines 5 Cess pool 8 Sewage lagoon 11 Fuel storage 15 Oil well/Gas well  
 3 Watertight sewer lines 6 Seepage pit 9 Feedyard 12 Fertilizer storage 16 Other (specify below)  
 CROPLAND-NOTHING  
 IMMEDIATE VICINITY  
 Direction from well? How many feet?

FROM	TO	LITHOLOGIC LOG	FROM	TO	PLUGGING INTERVALS
0	240	SURFACE, SAND & CLAY			
240	260	MED. COARSE SAND			
260	300	FINE TO MED. COARSE SAND			
300	320	FINE SAND			
320	340	SANDY PINK & LIGHT COLORED CLAY W/MED. COARSE SAND			
340	346	MED. COARSE SAND			
346	380	YELLOW CLAY W/BLUE CLAY			

7 CONTRACTOR'S OR LANDOWNER'S CERTIFICATION: This water well was (X) constructed, (2) reconstructed, or (3) plugged under my jurisdiction and was completed on (mo/day/year) 6/14/93 and this record is true to the best of my knowledge and belief. Kansas Water Well Contractor's License No. 225 This Water Well Record was completed on (mo/day/yr) 6/23/93 under the business name of KTM DRILLING, INC. by (signature) *Arnold Winters*