

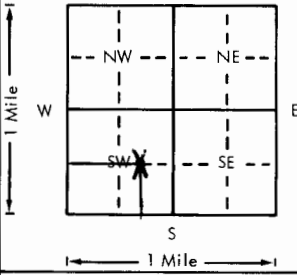
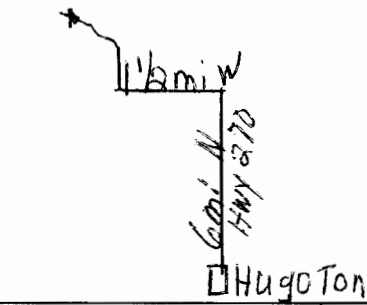
USE TYPEWRITER OR BALL
POINT PEN-PRESS FIRMLY,
PRINT CLEARLY.

WATER WELL RECORD
KSA 82a-1201-1215

Kansas Department of Health and
Environment-Division of Environment
(Water well Contractors)
Topeka, Kansas 66620

CWW Invoice No. 15931

Methodist #1

1. Location of well:	County Stevens	Section N$\frac{1}{2}$ 1/4 SE 1/4 SW 1/4	Section number 17	Township number T 32	Range number S R 37 E/W
2. Distance and direction from nearest town or city: 6mi North on Hwy 270 then 1 1/2 mi West Street address of well location if in city: North- North West to Location		3. Owner of well: Anadarko Production Company R.R. or street: c/o P. Gatlin Box 351 City, state, zip code: Liberal, Kansas 67901			
X Locate with "X" in section below: 		Sketch map: 		6. Bore hole dia. 9 in. Completion date June 15, 1979 Well depth 320 ft.	
5. Type and color of material		From	To	7. Cable tool <input checked="" type="checkbox"/> Rotary <input type="checkbox"/> Driven <input type="checkbox"/> Dug <input type="checkbox"/> Hollow rod <input type="checkbox"/> Jetted <input type="checkbox"/> Bored <input type="checkbox"/> Reverse rotary	
Surface		0	2	8. Use: <input type="checkbox"/> Domestic <input type="checkbox"/> Public supply <input type="checkbox"/> Industry <input type="checkbox"/> Irrigation <input type="checkbox"/> Air conditioning <input type="checkbox"/> Stock <input type="checkbox"/> Lawn <input checked="" type="checkbox"/> Oil field water <input type="checkbox"/> Other	
Clay		2	102	9. Casing: Material <input type="checkbox"/> Threaded <input type="checkbox"/> Welded <input type="checkbox"/> Surface <input type="checkbox"/> RMP <input type="checkbox"/> PVC <input checked="" type="checkbox"/> Weight 2.78 lbs./ft. Dia. 5 in. to 260 ft. depth Wall Thickness 2.78 inches or Dia. 5 in. to 260 ft. depth gage No. 256	
Medium to large sand		102	116	10. Screen: Manufacturer's name Sawed Type Sawed Dia. 5" Net/gauze .030 Length 60 Set between 260 ft. and 320 ft. Gravel pack? Yes Size range of material 1/8-1/16	
Clay 60% & fine sand 40%		116	162	11. Static water level: 121 ft. below land surface Date 6-15-79	
Clay 45% & fine sand 55%		162	204	12. Pumping level below land surfaces: _____ ft. after _____ hrs. pumping _____ g.p.m. _____ ft. after _____ hrs. pumping _____ g.p.m. Estimated maximum yield 65 g.p.m.	
Clay 40% & 60% fine sand		204	224	13. Water sample submitted: _____ mo./day/yr. Yes <input checked="" type="checkbox"/> No <input type="checkbox"/> Date _____	
Clay		224	266	14. Well head completion: 28 inches above grade Pitless adapter <input type="checkbox"/>	
Fine sand		266	320	15. Well grouted? Yes With: <input checked="" type="checkbox"/> Neat cement <input type="checkbox"/> Bentonite <input type="checkbox"/> Concrete Depth: From 0 ft. to 10 ft.	
(Use a second sheet if needed)				16. Nearest source of possible contamination: 100 ft. NE Oil well Direction NE Type Oil well Well disinfected upon completion? <input checked="" type="checkbox"/> Yes <input type="checkbox"/> No	
				17. Pump: <input checked="" type="checkbox"/> Not installed Manufacturer's name _____ Model number _____ HP _____ Volts _____ Length of drop pipe _____ ft. capacity _____ g.p.m. Type: _____ <input type="checkbox"/> Submersible <input type="checkbox"/> Turbine <input type="checkbox"/> Jet <input type="checkbox"/> Reciprocating <input type="checkbox"/> Centrifugal <input type="checkbox"/> Other	
18. Elevation:	19. Remarks:		20. Water well contractor's certification: This well was drilled under my jurisdiction and this report is true to the best of my knowledge and belief. 118 Carlisle Water Well Service Business name Box AA Liberal, Kansas Address 67901 Signed Edward E. Means Date 6-18-79 Authorized representative		
Topography: <input type="checkbox"/> Hill <input type="checkbox"/> Slope <input checked="" type="checkbox"/> Upland <input type="checkbox"/> Valley					