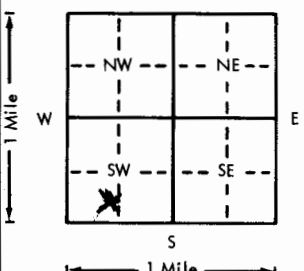


USE TYPEWRITER OR BALL POINT PEN-PRESS FIRMLY, PRINT CLEARLY.

WATER WELL RECORD
KSA 82a-1201-1215

Kansas Department of Health and Environment-Division of Environment (Water well Contractors) Topeka, Kansas 66620

1. Location of well:		County Stevens	Fraction SE 1/4 SW 1/4 SW 1/4	Section number 20	Township number T 32 S	Range number R 37 E/W
2. Distance and direction from nearest town or city: 4 N, 3/4 WEST OF HUGOTON, KS			3. Owner of well: Lawrence Wallace R.R. or street: 102 S. VAN BUREN City, state, zip code: HUGOTON KS			
4. Locate with "X" in section below: N W E S 1 Mile		Sketch map: 		6. Bore hole dia. 26 in. Completion date Well depth 570 ft. 3/25/97		
5. Type and color of material		From	To	7. <input type="checkbox"/> Cable tool <input checked="" type="checkbox"/> Rotary <input type="checkbox"/> Driven <input type="checkbox"/> Dug <input type="checkbox"/> Hollow rod <input type="checkbox"/> Jetted <input type="checkbox"/> Bored <input type="checkbox"/> Reverse rotary		
Overburden		0	2	8. Use: <input type="checkbox"/> Domestic <input type="checkbox"/> Public supply <input type="checkbox"/> Industry <input checked="" type="checkbox"/> Irrigation <input type="checkbox"/> Air conditioning <input type="checkbox"/> Stock <input type="checkbox"/> Lawn <input type="checkbox"/> Oil field water <input type="checkbox"/> Other		
Top Soil		2	120	9. Casing: Material Steel Height: Above or below Threaded <input type="checkbox"/> Welded <input checked="" type="checkbox"/> Surface 1 1/2 in. RMP <input type="checkbox"/> PVC <input type="checkbox"/> Weight 42.2 lbs./ft.		
Clay		120	140	Dia. 1 1/2 in. to 570 ft. depth; Wall Thickness: inches or Dia. <input type="checkbox"/> in. to <input type="checkbox"/> ft. depth; gage No. 1.250		
Fine Sd. & Clay		140	240	10. Screen: Manufacturer's name L.B. Foster		
Med. Sd. & Gravel w/Clay Strks.		240	280	Type Steel Dia. 1 1/2 " Slot/gauze 1/8 Length 40		
Fine to Med. Sd. w/Red Clay		280	300	Set between 350 ft. and 380 ft. 560 ft. and 570 ft.		
Med. Sd. & Clay		300	380	Gravel pack? <input checked="" type="checkbox"/> Yes <input type="checkbox"/> No Size range of material 1/8-1/4		
Fine Sd. & Clay w/Rock Strks.		380	400	11. Static water level: <input type="checkbox"/> mo./day/yr. 115 ft. below land surface Date 3-29-97		
Fine Sd. & Clay Strks.		400	520	12. Pumping level below land surfaces: NA <input type="checkbox"/> ft. after <input type="checkbox"/> hrs. pumping <input type="checkbox"/> g.p.m. <input type="checkbox"/> ft. after <input type="checkbox"/> hrs. pumping <input type="checkbox"/> g.p.m. Estimated maximum yield <input type="checkbox"/> g.p.m.		
Fine to Med. Sd. w/Rock & Clay		520	540	13. Water sample submitted: <input type="checkbox"/> mo./day/yr. Yes <input checked="" type="checkbox"/> No Date		
Sd. Stone & Clay		540	560	14. Well head completion: <input type="checkbox"/> Pitless adapter NA inches above grade		
Coarse Sd. & Clay		560	570	15. Well grouted? Yes With: <input checked="" type="checkbox"/> Neat cement <input type="checkbox"/> Bentonite <input type="checkbox"/> Concrete Depth: From 0 ft. to 10 ft.		
Red Bed		570	600	16. Nearest source of possible contamination: ft. <input type="checkbox"/> Direction <input type="checkbox"/> Type <input type="checkbox"/> Well disinfected upon completion? <input type="checkbox"/> Yes <input checked="" type="checkbox"/> No		
				17. Pump: <input checked="" type="checkbox"/> Not installed Manufacturer's name <input type="checkbox"/> Model number <input type="checkbox"/> HP <input type="checkbox"/> Volts <input type="checkbox"/> Length of drop pipe <input type="checkbox"/> ft. capacity <input type="checkbox"/> g.p.m. Type: <input type="checkbox"/> Submersible <input type="checkbox"/> Turbine <input type="checkbox"/> Jet <input type="checkbox"/> Reciprocating <input type="checkbox"/> Centrifugal <input type="checkbox"/> Other		
18. Elevation:		19. Remarks: 10A. 249-350 } MILL SLOT 380-560 } 10B Johnson Irr. Steel 1 1/2" .1000 slot 850-340; 560-570 16A. Creep Land		20. Water well contractor's certification: This well was drilled under my jurisdiction and this report is true to the best of my knowledge and belief. KIM DRILLING, INC. 225 Business name Address Box 1385, Guyman, Okla. License No. Signed [Signature] Date 4/1/97 Authorized representative		

32
37
20
SE 1/4 SW 1/4