


USE TYPEWRITER OR BALL POINT PEN-PRESS FIRMLY, PRINT CLEARLY.

WATER WELL RECORD
KSA 82a-1201-1215

Kansas Department of Health and Environment-Division of Environment (Water well Contractors) Topeka, Kansas 66620

1. Location of well:	County STERENS	Fraction SW 1/4 SW 1/4 SW 1/4	Section number 20	Township number T 32 S R 37 E/W	Range number
----------------------	--------------------------	---	-----------------------------	---	--------------

2. Distance and direction from nearest town or city: Street address of well location if in city:	4 m. -1W HUGOTON	3. Owner of well: R.R. or street: City, state, zip code:	Rodney Wallace R.R. HUGOTON KA 67951
---	-----------------------------------	--	---

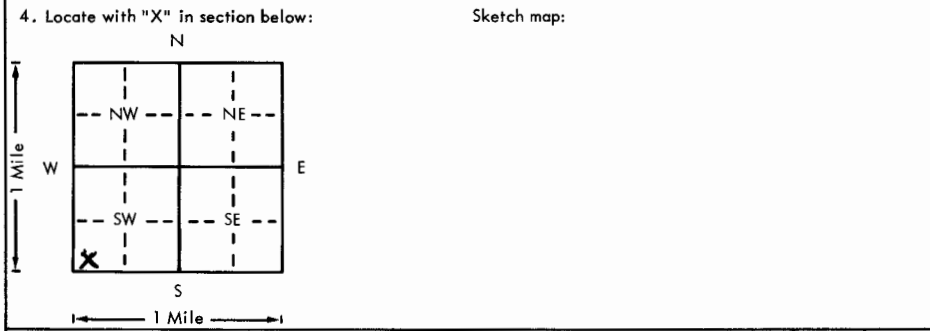

6. Bore hole dia. **10** in. Completion date **2-19-79**
Well depth **300** ft.

7. Cable tool Rotary Driven Dug
 Hollow rod Jetted Bored Reverse rotary

8. Use: Domestic Public supply Industry
 Irrigation Air conditioning Stock
 Lawn Oil field water Other

9. Casing: Material **2ch 40** Height: Above or below
Threaded Welded Surface **14** in.
RMP PVC Weight **140** lbs./ft.
Dia. **5** in. to **200** ft. depth Wall Thickness: inches or
Dia. in. to ft. depth gage No. **258**

5. Type and color of material	From	To
blow sand tan	0	20
sandy caliche	20	60
Brown silts	60	85
sand w/silt balls	85	120
Caliche tan & white	120	140
Silts w/sand	140	155
Sand coarse brown	155	185
Silts & clays	185	205
silt balls - small redish-tan w/some sand & rock shelles	205	380
(Use a second sheet if needed)		

10. Screen: Manufacturer's name **Slocum**

Type **Saw cut** Dia. **5"**
Slot/gauze **1/8"** Length **100'**
Set between **160-180** ft. and **180-200** ft.
200-220 ft. and **240-260** ft. **280-300**
Gravel pack? Size range of material **1/2 - 1/4**

11. Static water level: mo./day/yr.
125 ft. below land surface Date **2-20-79**

12. Pumping level below land surfaces:
4 ft. after **1** hrs. pumping **22** g.p.m.
 ft. after hrs. pumping g.p.m.
Estimated maximum yield g.p.m.

13. Water sample submitted: mo./day/yr.
 Yes No Date

14. Well head completion:
 Pitless adapter **18** inches above grade

15. Well grouted?
With: Neat cement Bentonite Concrete
Depth: From **4** ft. to **14** ft.

16. Nearest source of possible contamination:
ft. **60** Direction **N-W** Type **septic**
Well disinfected upon completion? Yes No

17. Pump: Not installed
Manufacturer's name **Beda**
Model number **19018P** HP **2** Volts **220**
Length of drop pipe ft. capacity g.p.m.
Type:
 Submersible Turbine
 Jet Reciprocating
 Centrifugal Other

18. Elevation:	19. Remarks:
Topography: <input type="checkbox"/> Hill <input checked="" type="checkbox"/> Slope <input type="checkbox"/> Upland <input type="checkbox"/> Valley	

20. Water well contractor's certification:
This well was drilled under my jurisdiction and this report is true to the best of my knowledge and belief.
Slocum Drilling **127**
Business name License No.
Address **HUGOTON KA**
Signed **Paul Slocum** Date **4-7**
Authorized representative

T
R
W
E
S
C
1/4
1/4
1/4
1/4
 32
37
20
505
505