


1 LOCATION OF WATER WELL:	Fraction	Section Number	Township Number	Range Number
County: Stevens	NE 1/4 SE 1/4 NE 1/4	25	T 32 S	R 37 E/W

Distance and direction from nearest town or city street address of well if located within city?  
 3 1/2 miles north and 3 east of Hugoton, Kansas

2 WATER WELL OWNER: Bobby Campbell  
 RR#, St. Address, Box #: Hugoton, Kansas 67951  
 City, State, ZIP Code: Board of Agriculture, Division of Water Resources  
 Application Number:

3 LOCATE WELL'S LOCATION WITH AN "X" IN SECTION BOX:

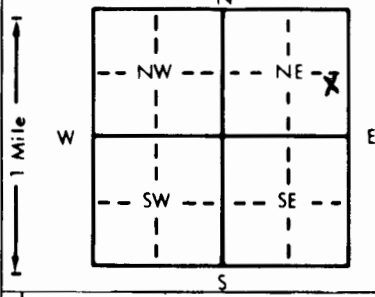

4 DEPTH OF COMPLETED WELL: 24.5 ft. ELEVATION: slope  
 Depth(s) Groundwater Encountered 1. 120 ft. 2. ft. 3. ft.  
 WELL'S STATIC WATER LEVEL: 12.0 ft. below land surface measured on mo/day/yr 12/16/91  
 Pump test data: Well water was ft. after NA hours pumping gpm  
 Est. Yield: NA Well water was ft. after NA hours pumping gpm  
 Bore Hole Diameter: 9 7/8 in. to 2.45 ft., and in. to ft.  
 WELL WATER TO BE USED AS:  
 1 Domestic 3 Feedlot 6 Oil field water supply 9 Dewatering 12 Other (Specify below)  
 2 Irrigation 4 Industrial 7 Lawn and garden only 10 Monitoring well  
 Was a chemical/bacteriological sample submitted to Department? Yes No X; If yes, mo/day/yr sample was submitted  
 Water Well Disinfected? Yes X No

5 TYPE OF BLANK CASING USED:  
 1 Steel 3 RMP (SR) 5 Wrought iron 8 Concrete tile CASING JOINTS: Glued X Clamped  
 2 PVC 4 ABS 6 Asbestos-Cement 9 Other (specify below) Welded  
 7 Fiberglass Threaded

Blank casing diameter: 5 in. to 20.5 ft., Dia. in. to ft., Dia. in. to ft.  
 Casing height above land surface: 18 in., weight schedule 200 lbs./ft. Wall thickness or gauge No. SDR 21

TYPE OF SCREEN OR PERFORATION MATERIAL:  
 1 Steel 3 Stainless steel 5 Fiberglass 8 RMP (SR) 10 Asbestos-cement 11 Other (specify)  
 2 Brass 4 Galvanized steel 6 Concrete tile 9 ABS 12 None used (open hole)

SCREEN OR PERFORATION OPENINGS ARE:  
 1 Continuous slot 3 Mill slot 5 Gauzed wrapped 8 Saw cut 11 None (open hole)  
 2 Louvered shutter 4 Key punched 6 Wire wrapped 9 Drilled holes  
 7 Torch cut 10 Other (specify)

SCREEN-PERFORATED INTERVALS: From 20.5 ft. to 24.5 ft. From ft. to ft. ft.  
 From ft. to ft. From ft. to ft. ft.  
 GRAVEL PACK INTERVALS: From 24 ft. to 24.5 ft. From ft. to ft. ft.  
 From ft. to ft. From ft. to ft. ft.

6 GROUT MATERIAL: 1 Neat cement 2 Cement grout 3 Bentonite 4 Other  
 Grout intervals: From 4 ft. to 24 ft. From ft. to ft. From ft. to ft. ft.

What is the nearest source of possible contamination:  
 1 Septic tank 4 Lateral lines 7 Pit privy 10 Livestock pens 14 Abandoned water well  
 2 Sewer lines 5 Cess pool 8 Sewage lagoon 11 Fuel storage 15 Oil well/Gas well  
 3 Watertight sewer lines 6 Seepage pit 9 Feedyard 12 Fertilizer storage 16 Other (specify below)  
 13 Insecticide storage  
 Direction from well? south How many feet? 150

FROM	TO	LITHOLOGIC LOG	FROM	TO	PLUGGING INTERVALS
0	2	Surface			
2	30	Fine sand and clay			
30	80	Brown clay			
80	90	Cemented sand			
90	105	Fine sand			
105	118	Coarse sand and gravel			
118	190	Brown clay w/hard lime rock			
190	210	Brown clay w/fine sand			
210	245	Medium to coarse sand w/clay breakers			
245	255	Brown sandy clay			

7 CONTRACTOR'S OR LANDOWNER'S CERTIFICATION: This water well was (1) constructed, (2) reconstructed, or (3) plugged under my jurisdiction and was completed on (mo/day/year) December 16, 1991 and this record is true to the best of my knowledge and belief. Kansas Water Well Contractor's License No. 164 This Water Well Record was completed on (mo/day/yr) 3/19/92 under the business name of Houck Bros. Drilling co. by signature M. Beard