


1 LOCATION OF WATER WELL: County: **Stevens** Fraction: **SE 1/4 SE 1/4 SE 1/4** Section Number: **26** Township Number: **T 32 S** Range Number: **R 37 EW**

Distance and direction from nearest town or city street address of well if located within city? **3 miles north, 2 east of Hugoton, Ks.**

2 WATER WELL OWNER: **Jerry Clark**
 RR#, St. Address, Box #: **613 So. Harrison**
 City, State, ZIP Code: **Hugoton, Ks. 67951**
 Board of Agriculture, Division of Water Resources
 Application Number:

3 LOCATE WELL'S LOCATION WITH AN "X" IN SECTION BOX:

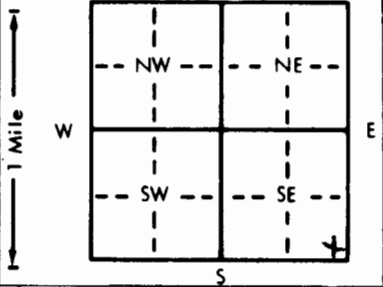

4 DEPTH OF COMPLETED WELL: **243** ft. ELEVATION: **slope**
 Depth(s) Groundwater Encountered: 1. **100** ft. 2. **137** ft. 3. **243** ft.
 WELL'S STATIC WATER LEVEL: **100** ft. below land surface measured on **1/12/83**
 Pump test data: Well water was **137** ft. after **10** hours pumping **15** gpm
 Est. Yield: **25** gpm; Well water was **137** ft. after **10** hours pumping **15** gpm
 Bore Hole Diameter: **9 7/8** in. to **243** ft., and **9 7/8** in. to **243** ft.
 WELL WATER TO BE USED AS:
 5 Public water supply 8 Air conditioning 11 Injection well
 1 Domestic 3 Feedlot 6 Oil field water supply 9 Dewatering 12 Other (Specify below)
 2 Irrigation 4 Industrial 7 Lawn and garden only 10 Observation well
 Was a chemical/bacteriological sample submitted to Department? Yes No X; If yes, mo/day/yr sample was submitted
 Water Well Disinfected? Yes X No

5 TYPE OF BLANK CASING USED:
 1 Steel 3 RMP (SR) 5 Wrought iron 8 Concrete tile CASING JOINTS: Glued X Clamped
 2 PVC 4 ABS 6 Asbestos-Cement 9 Other (specify below) & riveted Welded
 7 Fiberglass Threaded
 Blank casing diameter: ~~127~~ **127** in. to **127** ft., Dia **5** in. to **223** ft., Dia **5** in. to **223** ft.
 Casing height above land surface: **18** in., weight **18** lbs./ft. Wall thickness or gauge No. **schedule 200**

TYPE OF SCREEN OR PERFORATION MATERIAL:
 1 Steel 3 Stainless steel 5 Fiberglass 7 PVC 10 Asbestos-cement
 2 Brass 4 Galvanized steel 6 Concrete tile 8 RMP (SR) 11 Other (specify)
 9 ABS 12 None used (open hole)

SCREEN OR PERFORATION OPENINGS ARE:
 1 Continuous slot 3 Mill slot 5 Gauzed wrapped 8 Saw cut 11 None (open hole)
 2 Louvered shutter 4 Key punched 6 Wire wrapped 9 Drilled holes
 7 Torch cut 10 Other (specify)

SCREEN-PERFORATED INTERVALS: From **127** ft. to **137** ft., From **137** ft. to **243** ft.
 From **223** ft. to **243** ft., From **243** ft. to **243** ft.
 GRAVEL PACK INTERVALS: From **13** ft. to **243** ft., From **243** ft. to **243** ft.

6 GROUT MATERIAL: 1 Neat cement 2 Cement grout 3 Bentonite 4 Other
 Grout Intervals: From **3** ft. to **13** ft., From **13** ft. to **243** ft., From **243** ft. to **243** ft.

What is the nearest source of possible contamination:
 1 Septic tank 4 Lateral lines 7 Pit privy 10 Livestock pens 14 Abandoned water well
 2 Sewer lines 5 Cess pool 8 Sewage lagoon 11 Fuel storage 15 Oil well/Gas well
 3 Watertight sewer lines 6 Seepage pit 9 Feedyard 12 Fertilizer storage 16 Other (specify below)
 13 Insecticide storage
 Direction from well? **Southeast** How many feet? **300**

FROM	TO	LITHOLOGIC LOG	FROM	TO	LITHOLOGIC LOG
0	2	Surface			
2	8	Sand			
8	30	Clay			
30	45	Sandy clay and fine sand			
45	125	Brown clay			
125	135	Medium to coarse sand			
135	224	Brown clay			
224	243	Sandy clay w/fine to medium sand			
243	255	Clay			

7 CONTRACTOR'S OR LANDOWNER'S CERTIFICATION: This water well was (1) constructed, (2) reconstructed, or (3) plugged under my jurisdiction and was completed on (mo/day/year) **January 11, 1983** and this record is true to the best of my knowledge and belief. Kansas Water Well Contractor's License No. **164** This Water Well Record was completed on (mo/day/yr) **June 17, 1983** under the business name of **Houck Bros. Drilling Co.** by (signature) **Wesley Beard**

INSTRUCTIONS: Use typewriter or ball point pen, PLEASE PRESS FIRMLY and PRINT clearly. Please fill in blanks, underline or circle the correct answers. Send top three copies to Kansas Department of Health and Environment, Division of Environment, Environmental Geology Section, Topeka, KS 66620. Send one to WATER WELL OWNER and retain one for your records.

DP

OFFICE USE ONLY
T
32
R
37
EWD
SEC. 26
SE 1/4
SE 1/4
SE 1/4