


USE TYPEWRITER OR BALL POINT PEN—PRESS FIRMLY, PRINT CLEARLY.

WATER WELL RECORD
KSA 82a-1201-1215

Kansas Department of Health and Environment—Division of Environment
(Water well Contractors)
Topeka, Kansas 66620

1. Location of well:	County Stevens	Fraction SW $\frac{1}{4}$ SW $\frac{1}{4}$ SW $\frac{1}{4}$	Section number 26	Township number T 32 S R	Range number 37	E/W
----------------------	--------------------------	--	-----------------------------	------------------------------------	---------------------------	-----

2. Distance and direction from nearest town or city: 56 2 north 1 east Street address of well location if in city:	3. Owner of well: Micheal Willis R.R. or street: Star Rt. 2, Box 3C City, state, zip code: Hugoton, Ks. 67951
---	---

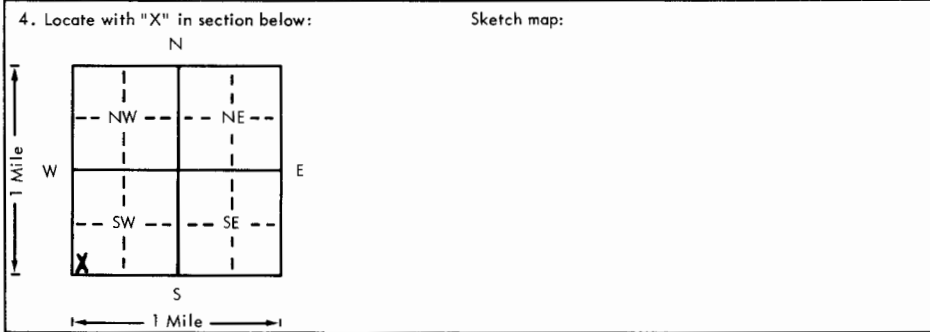

6. Bore hole dia. <u>10</u> in. Completion date <u>4/30/79</u> Well depth <u>255</u> ft.
7. <input checked="" type="checkbox"/> Cable tool <input checked="" type="checkbox"/> Rotary <input type="checkbox"/> Driven <input type="checkbox"/> Dug <input type="checkbox"/> Hollow rod <input type="checkbox"/> Jetted <input type="checkbox"/> Bored <input type="checkbox"/> Reverse rotary
8. Use: <input checked="" type="checkbox"/> Domestic <input type="checkbox"/> Public supply <input type="checkbox"/> Industry <input type="checkbox"/> Irrigation <input type="checkbox"/> Air conditioning <input type="checkbox"/> Stock <input type="checkbox"/> Lawn <input type="checkbox"/> Oil field water <input type="checkbox"/> Other
9. Casing: Material <u>styrene</u> Weight: <u>12</u> lbs./ft. <u>glued and riveted</u> Threaded <input type="checkbox"/> Welded <input type="checkbox"/> Surface <u>(12)</u> in. RMP <input type="checkbox"/> PVC <input type="checkbox"/> Weight <u>12</u> lbs./ft. Dia. <u>5</u> in. to <u>195</u> ft. depth Wall Thickness: inches or Dia. <u>5</u> in. to <u>195</u> ft. depth gage No. <u>.320</u>

5. Type and color of material	From	To
<u>Surface</u>	<u>0</u>	<u>2</u>
<u>Clay</u>	<u>2</u>	<u>15</u>
<u>Fine sand</u>	<u>15</u>	<u>30</u>
<u>Clay w/small sand strips</u>	<u>30</u>	<u>195</u>
<u>Yellow chalk, clay & sandstone</u> <u>25%</u>	<u>195</u>	<u>205</u>
<u>Clay and sandstone</u> <u>tight</u> <u>50%</u>	<u>205</u>	<u>235</u>
<u>Blue shale</u>	<u>235</u>	<u>310</u>

10. Screen: Manufacturer's name <u>Sunflower</u> Type <u>styrene</u> Dia. <u>5"</u> Slot/gauze <u>1/16"</u> Length <u>40'</u> Set between <u>245</u> ft. and <u>255</u> ft. Gravel pack? <input checked="" type="checkbox"/> Size range of material <u>1/4 x 5/8"</u>
11. Static water level: <u>130</u> ft. below land surface Date <u>4/30/79</u>
12. Pumping level below land surfaces: <u>210</u> ft. after <u>2</u> hrs. pumping <u>10</u> g.p.m. Estimated maximum yield <u>15</u> g.p.m.
13. Water sample submitted: <u>mo./day/yr.</u> Yes <input checked="" type="checkbox"/> No <input type="checkbox"/> Date <u>4/30/79</u>
14. Well head completion: <input checked="" type="checkbox"/> Pitless adapter <u>12</u> inches above grade
15. Well grouted? <input checked="" type="checkbox"/> With: <input checked="" type="checkbox"/> Neat cement <input type="checkbox"/> Bentonite <input type="checkbox"/> Concrete Depth: From <u>0</u> ft. to <u>10</u> ft.
17. Pump: <input checked="" type="checkbox"/> Not installed Manufacturer's name _____ Model number _____ HP _____ Volts _____ Length of drop pipe _____ ft. capacity _____ g.p.m. Type: <input type="checkbox"/> Submersible <input type="checkbox"/> Turbine <input type="checkbox"/> Jet <input type="checkbox"/> Reciprocating <input type="checkbox"/> Centrifugal <input type="checkbox"/> Other

18. Elevation:	19. Remarks: This well was drilled in a field for a new home
----------------	--

20. Water well contractor's certification: This well was drilled under my jurisdiction and this report is true to the best of my knowledge and belief. Houck Bros. Drlg. Co. 164 Business name <u>Box 487, Ulysses, Ks.</u> License No. _____ Address _____ Signed <u>M. Beard</u> Date <u>7/23/79</u> Authorized representative

3 2 3 7 2
 T
 R
 W
 Sec
 1/4
 1/4
 1/4