


1 LOCATION OF WATER WELL: County: **Stevens** Fraction: **NC 1/4 N Center 1/4 SE 1/4** Section Number: **28** Township Number: **T 32 S** Range Number: **R 37 E/W**

Distance and direction from nearest town or city street address of well if located within city?

2 North of Hugoton West into

2 WATER WELL OWNER: **Lee Reynolds** RR#, St. Address, Box #: **135 S. Monroe** City, State, ZIP Code: **Hugoton, KS 67951** Board of Agriculture, Division of Water Resources Application Number:

3 LOCATE WELL'S LOCATION WITH AN "X" IN SECTION BOX: 4 DEPTH OF COMPLETED WELL: **370** ft. ELEVATION:

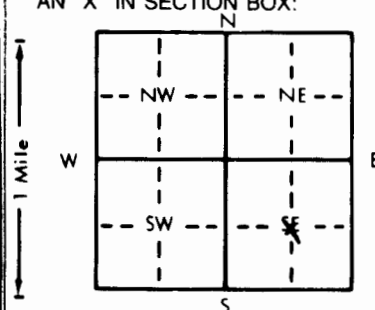

Depth(s) Groundwater Encountered 1. **240** ft. 2. ft. 3. ft.
 WELL'S STATIC WATER LEVEL **130** ft. below land surface measured on mo/day/yr **10-15-90**
 Pump test data: Well water was **135** ft. after **2** hours pumping **30** gpm
 Est. Yield **35** gpm: Well water was ft. after hours pumping gpm
 Bore Hole Diameter . . . **9** in. to **370** ft., and in. to ft.
 WELL WATER TO BE USED AS: 5 Public water supply 8 Air conditioning 11 Injection well
 1 Domestic 3 Feedlot 6 Oil field water supply 9 Dewatering 12 Other (Specify below)
 2 Irrigation 4 Industrial 7 Lawn and garden only 10 Monitoring well
 Was a chemical/bacteriological sample submitted to Department? Yes. No **X**; If yes, mo/day/yr sample was submitted
 Water Well Disinfected? Yes **X** No

5 TYPE OF BLANK CASING USED: 1 Steel 3 RMP (SR) 5 Wrought iron 8 Concrete tile CASING JOINTS: Glued **X** Clamped
 2 PVC 4 ABS 6 Asbestos-Cement 9 Other (specify below) Welded
 7 Fiberglass Threaded.

Blank casing diameter **5** in. to **330** ft., Dia. in. to ft., Dia. in. to ft.
 Casing height above land surface **14** in., weight **200 & 250** lbs./ft. Wall thickness or gauge No. **.265 & .375**

TYPE OF SCREEN OR PERFORATION MATERIAL: 1 Steel 3 Stainless steel 5 Fiberglass 7 PVC 10 Asbestos-cement
 2 Brass 4 Galvanized steel 6 Concrete tile 8 RMP (SR) 11 Other (specify)
 9 ABS 12 None used (open hole)

SCREEN OR PERFORATION OPENINGS ARE: 1 Continuous slot 3 Mill slot 5 Gauzed wrapped 8 Saw cut 11 None (open hole)
 2 Louvered shutter 4 Key punched 6 Wire wrapped 9 Drilled holes
 7 Torch cut 10 Other (specify)

SCREEN-PERFORATED INTERVALS: From **330** ft. to **370** ft. From ft. to ft.
 From ft. to ft. From ft. to ft.
 GRAVEL PACK INTERVALS: From **125** ft. to **370** ft. From ft. to ft.
 From ft. to ft. From ft. to ft.

6 GROUT MATERIAL: 1 Neat cement 2 Cement grout 3 Bentonite 4 Other **Hole plug**
 Grout Intervals: From ft. to ft., From ft. to ft., From ft. to ft.

What is the nearest source of possible contamination: **None** 10 Livestock pens 14 Abandoned water well
 1 Septic tank 4 Lateral lines 7 Pit privy 11 Fuel storage 15 Oil well/Gas well
 2 Sewer lines 5 Cess pool 8 Sewage lagoon 12 Fertilizer storage 16 Other (specify below)
 3 Watertight sewer lines 6 Seepage pit 9 Feedyard 13 Insecticide storage

Direction from well? **Pasture Well** How many feet?

FROM	TO	LITHOLOGIC LOG	FROM	TO	PLUGGING INTERVALS
0	130	Overburden			
130	160	Medium sand			
160	180	Fine and medium sand			
180	200	Fine sand and clay			
200	220	Fine sand and clay			
220	240	Fine sand and clay			
240	260	Fine sand and clay			
260	280	Fine sand and red clay			
280	300	Fine sand and red clay			
300	320	Fine sand and red clay			
320	340	Fine sand and red clay			
340	360	Fine sand and red clay			
360	370	Fine sand and Redbed @370			

7 CONTRACTOR'S OR LANDOWNER'S CERTIFICATION: This water well was (1) constructed, (2) reconstructed, or (3) plugged under my jurisdiction and was completed on (mo/day/year) **10-15-90** and this record is true to the best of my knowledge and belief. Kansas Water Well Contractor's License No. **142** This Water Well Record was completed on (mo/day/yr) **10-17-90** under the business name of **T & W Water Well Service** by (signature) *[Signature]*

OFFICE USE ONLY T R E W SEC. 1/4 1/4 1/4 1/4