


1 LOCATION OF WATER WELL: County: STEVENS	Fraction NE ¼ NE ¼ SW ¼	Section Number 13	Township Number T 32 S	Range Number R 38 E/W
--	----------------------------	----------------------	---------------------------	--------------------------

Distance and direction from nearest town or city street address of well if located within city?
 THREE (3) MILES WEST AND FIVE AND ONE-HALF (5½) MILES NORTH OF THE NORTHWEST CORNER OF HUGOTON.

2 WATER WELL OWNER: UNITED PENTECOSTAL CHURCH
 RR#, St. Address, Box #: P.O. BOX 998
 City, State, ZIP Code: HUGOTON, KS 67951
 Board of Agriculture, Division of Water Resources
 Application Number: 025999

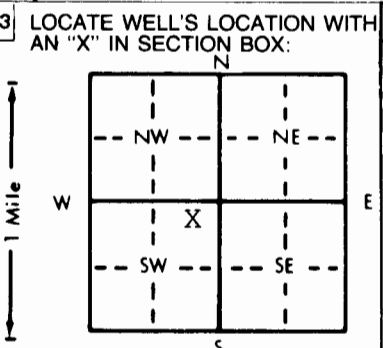

4 DEPTH OF COMPLETED WELL: 550 ft. ELEVATION: _____ ft.
 Depth(s) Groundwater Encountered 1. _____ ft. 2. _____ ft. 3. _____ ft.
 WELL'S STATIC WATER LEVEL: 189 ft. below land surface measured on mo/day/yr 12/14/95
 Pump test data: Well water was _____ ft. after _____ hours pumping _____ gpm
 Est. Yield _____ gpm: Well water was _____ ft. after _____ hours pumping _____ gpm
 Bore Hole Diameter: 26 in. to 550 ft., and _____ in. to _____ ft.
 WELL WATER TO BE USED AS:
 1 Domestic 2 Irrigation 3 Feedlot 4 Industrial 5 Public water supply 6 Oil field water supply 7 Lawn and garden only 8 Air conditioning 9 Dewatering 10 Monitoring well 11 Injection well 12 Other (Specify below)
 Was a chemical/bacteriological sample submitted to Department? Yes _____ No X If yes, mo/day/yr sample was submitted _____
 Water Well Disinfected? Yes _____ No _____

5 TYPE OF BLANK CASING USED:
 1 Steel 2 PVC 3 RMP (SR) 4 ABS 5 Wrought iron 6 Asbestos-Cement 7 Fiberglass 8 Concrete tile 9 Other (specify below)
 CASING JOINTS: Glued _____ Clamped _____ Welded X Threaded _____
 Blank casing diameter: 16 in. to 550 ft., Dia _____ in. to _____ ft., Dia _____ in. to _____ ft.
 Casing height above land surface: 12 in., weight 42.5 lbs./ft. Wall thickness or gauge No. 250
 TYPE OF SCREEN OR PERFORATION MATERIAL:
 1 Steel 2 Brass 3 Stainless steel 4 Galvanized steel 5 Fiberglass 6 Concrete tile 7 PVC 8 RMP (SR) 9 ABS 10 Asbestos-cement 11 Other (specify) _____ 12 None used (open hole)
 SCREEN OR PERFORATION OPENINGS ARE:
 1 Continuous slot 2 Louvered shutter 3 Mill slot 4 Key punched 5 Gauzed wrapped 6 Wire wrapped 7 Torch cut 8 Saw cut 9 Drilled holes 10 Other (specify) _____ 11 None (open hole)
 SCREEN-PERFORATED INTERVALS: From SCREEN 335 ft. to 355 ft., From PERF. 355 ft. to 440 ft.
 From SCREEN 440 ft. to 480 ft., From PERF. 480 ft. to 530 ft.
 GRAVEL PACK INTERVALS: From 20 ft. to 550 ft., From SCREEN 530 ft. to 550 ft.
 From _____ ft. to _____ ft., From _____ ft. to _____ ft.

6 GROUT MATERIAL: 1 Neat cement 2 Cement grout 3 Bentonite 4 Other _____
 Grout Intervals: From 0 ft. to 20 ft., From _____ ft. to _____ ft., From _____ ft. to _____ ft.
 What is the nearest source of possible contamination:
 1 Septic tank 2 Sewer lines 3 Watertight sewer lines 4 Lateral lines 5 Cess pool 6 Seepage pit 7 Pit privy 8 Sewage lagoon 9 Feedyard 10 Livestock pens 11 Fuel storage 12 Fertilizer storage 13 Insecticide storage 14 Abandoned water well 15 Oil well/Gas well 16 Other (specify below) CROP LAND. NOTHING IMMEDIATE VICINITY.
 Direction from well? _____ How many feet? _____

FROM	TO	LITHOLOGIC LOG	FROM	TO	PLUGGING INTERVALS
0	220	SURFACE, SAND & CLAY			
220	280	FINE SAND			
280	320	BROWN CLAY W/FINE SAND			
320	460	FINE TO MED. SAND			
460	550	FINE TO MED. COARSE SAND			
550	560	RED CLAY-FIRM			

7 CONTRACTOR'S OR LANDOWNER'S CERTIFICATION: This water well was (1) constructed, (2) deconstructed, or (3) plugged under my jurisdiction and was completed on (mo/day/year) 12/14/95 and this record is true to the best of my knowledge and belief. Kansas Water Well Contractor's License No. 225 This Water Well Record was completed on (mo/day/yr) 4/15/96 under the business name of KTM DRILLING, INC. by (signature) *Donald Winter*

OFFICE USE ONLY