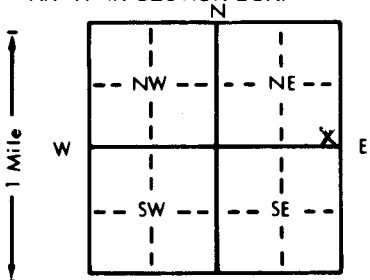


1 LOCATION OF WATER WELL: Fraction Section Number Township Number Range Number
 County: Stevens SE 1/4 NE 1/4 NE 1/4 15 T 32 S R 38 EW

Distance and direction from nearest town or city street address of well if located within city?
4 W. 5 N. of Hugoton

2 WATER WELL OWNER: Walter Hittle
 RR#, St. Address, Box #: HC-01 Board of Agriculture, Division of Water Resources
 City, State, ZIP Code: Hugoton, Ks 67951 Application Number:

3 LOCATE WELL'S LOCATION WITH AN "X" IN SECTION BOX:


4 DEPTH OF COMPLETED WELL: 4.73 ft. ELEVATION:
 Depth(s) Groundwater Encountered 1. 1.92 ft. 2. ft. 3. ft.
 WELL'S STATIC WATER LEVEL . . . 1.92 . . . ft. below land surface measured on mo/day/yr Oct. 12, 1998.
 Pump test data: Well water was . . . 1.92 . . . ft. after . . . 3 . . . hours pumping . . . 1.4 . . . gpm
 Est. Yield 7.0 . . . gpm: Well water was ft. after hours pumping gpm
 Bore Hole Diameter . . . 9.7/8 in. to 4.73 ft., and in. to ft.
 WELL WATER TO BE USED AS: 5 Public water supply 8 Air conditioning 11 Injection well
 1 Domestic 3 Feedlot 6 Oil field water supply 9 Dewatering 12 Other (Specify below)
 2 Irrigation 4 Industrial 7 Lawn and garden only 10 Monitoring well Stock well
 Was a chemical/bacteriological sample submitted to Department? Yes No X; If yes, mo/day/yr sample was sub-
 mitted Water Well Disinfected? Yes X No

5 TYPE OF BLANK CASING USED: 5 Wrought iron 8 Concrete tile CASING JOINTS: Glued Clamped
 1 Steel 3 RMP (SR) 6 Asbestos-Cement 9 Other (specify below) Welded
2 PVC 4 ABS 7 Fiberglass Threaded
 Blank casing diameter . . . 5 in. to 4.73 ft., Dia in. to ft., Dia in. to ft.
 Casing height above land surface . . . 18 in., weight 200PSI 4' to 233' lbs./ft. Wall thickness or gauge No. 233' to 473' SDR 17
 TYPE OF SCREEN OR PERFORATION MATERIAL: 7 PVC 10 Asbestos-cement
 1 Steel 3 Stainless steel 5 Fiberglass 8 RMP (SR) 11 Other (specify)
 2 Brass 4 Galvanized steel 6 Concrete tile 9 ABS 12 None used (open hole)
 SCREEN OR PERFORATION OPENINGS ARE: 5 Gauzed wrapped 8 Saw cut 11 None (open hole)
 1 Continuous slot 3 Mill slot 6 Wire wrapped 9 Drilled holes
 2 Louvered shutter 4 Key punched 7 Torch cut 10 Other (specify)
 SCREEN-PERFORATED INTERVALS: From . . . 4.13 . . . ft. to . . . 4.73 . . . ft., From ft. to ft.
 From ft. to ft., From ft. to ft.
 GRAVEL PACK INTERVALS: From . . . 2.4 . . . ft. to . . . 4.73 . . . ft., From ft. to ft.
 From ft. to ft., From ft. to ft.

6 GROUT MATERIAL: 1 Neat cement 2 Cement grout 3 Bentonite 4 Other
 Grout Intervals: From . . . 4 . . . ft. to . . . 2.4 . . . ft., From ft. to ft., From ft. to ft.
 What is the nearest source of possible contamination: 10 Livestock pens 14 Abandoned water well
 1 Septic tank 4 Lateral lines 7 Pit privy 11 Fuel storage 15 Oil well/Gas well
 2 Sewer lines 5 Cess pool 8 Sewage lagoon 12 Fertilizer storage 16 Other (specify below)
 3 Watertight sewer lines 6 Seepage pit 9 Feedyard 13 Insecticide storage Water tanks
 Direction from well? North How many feet? 1000

FROM	TO	LITHOLOGIC LOG	FROM	TO	PLUGGING INTERVALS
0	2	Surface			
2	60	Fine sand			
60	85	Fine to med sand			
85	190	Brown & gray clay			
190	237	Gray clay W/fine sand strips			
237	380	Coarse sand W/small clay B			
380	400	Sandy sand			
400	467	Coarse sand			
467	480	Red clay			

7 CONTRACTOR'S OR LANDOWNER'S CERTIFICATION: This water well was (1) constructed, (2) reconstructed, or (3) plugged under my jurisdiction and was completed on (mo/day/year) . . . OCT. 12, 1998 . . . and this record is true to the best of my knowledge and belief. Kansas Water Well Contractor's License No. . . 164 . . . This Water Well Record was completed on (mo/day/yr) under the business name of Houck Bros. Drilling by (signature) Gerald Houck