


1 LOCATION OF WATER WELL: Fraction SW 1/4 SW 1/4 SE 1/4 Section Number 26 Township Number T 32 S Range Number R 38 EW  
 County: Stevens

Distance and direction from nearest town or city street address of well if located within city?

3 west 3 north of Hugoton

2 WATER WELL OWNER: Doug Titus  
 RR#, St. Address, Box #: PO Box 14  
 City, State, ZIP Code: Hugoton KS  
 Board of Agriculture, Division of Water Resources  
 Application Number:

3 LOCATE WELL'S LOCATION WITH AN "X" IN SECTION BOX: 4 DEPTH OF COMPLETED WELL 435 ft. ELEVATION: \_\_\_\_\_

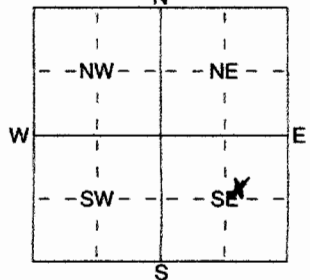

Depth(s) Groundwater Encountered 1 185 ft. 2 \_\_\_\_\_ ft. 3 \_\_\_\_\_ ft.  
 WELL'S STATIC WATER LEVEL 185 ft. below land surface measured on mo/day/yr 7/14/06  
 Pump test data: Well water was \_\_\_\_\_ ft. after \_\_\_\_\_ hours pumping \_\_\_\_\_ gpm  
 Est. Yield \_\_\_\_\_ gpm: Well water was \_\_\_\_\_ ft. after \_\_\_\_\_ hours pumping \_\_\_\_\_ gpm  
 WELL WATER TO BE USED AS:  
 1 Domestic     3 Feedlot     6 Oil field water supply     9 Dewatering     12 Other (Specify below)  
 2 Irrigation     4 Industrial     7 Domestic (lawn & garden)     10 Monitoring well

Was a chemical/bacteriological sample submitted to Department? Yes \_\_\_\_\_ No X; If yes, mo/day/yr sample was submitted  
 Water Well Disinfected? Yes X No \_\_\_\_\_

5 TYPE OF BLANK CASING USED:  
 1 Steel     3 RMP (SR)     5 Wrought iron     8 Concrete tile    CASING JOINTS: Glued \_\_\_\_\_ Clamped \_\_\_\_\_  
 2 PVC     4 ABS     6 Asbestos-Cement     9 Other (specify below)    Welded \_\_\_\_\_  
 \_\_\_\_\_     7 Fiberglass    \_\_\_\_\_    Threaded \_\_\_\_\_

Blank casing diameter 5 in. to 4.35 ft., Dia \_\_\_\_\_ in. to \_\_\_\_\_ ft., Dia \_\_\_\_\_ in. to \_\_\_\_\_ ft.  
 Casing height above land surface 24 in., weight \_\_\_\_\_ lbs./ft. Wall thickness or gauge No. SDR 21

TYPE OF SCREEN OR PERFORATION MATERIAL:  
 1 Steel     3 Stainless Steel     5 Fiberglass     7 PVC     10 Asbestos-Cement  
 2 Brass     4 Galvanized Steel     6 Concrete tile     8 RMP (SR)     11 Other (Specify) \_\_\_\_\_  
 \_\_\_\_\_     9 ABS    \_\_\_\_\_     12 None used (open hole)

SCREEN OR PERFORATION OPENINGS ARE:  
 1 Continuous slot     3 Mill slot     5 Gauzed wrapped     8 Saw cut     11 None (open hole)  
 2 Louvered shutter     4 Key punched     6 Wire wrapped     9 Drilled holes

SCREEN-PERFORATED INTERVALS: From 355 ft. to 435 ft., From \_\_\_\_\_ ft. to \_\_\_\_\_ ft.  
 GRAVEL PACK INTERVALS: From 25 ft. to 435 ft., From \_\_\_\_\_ ft. to \_\_\_\_\_ ft.

6 GROUT MATERIAL:  1 Neat cement     2 Cement grout     3 Bentonite     4 Other \_\_\_\_\_  
 Grout intervals: From 5 ft. to 25 ft., From \_\_\_\_\_ ft. to \_\_\_\_\_ ft., From \_\_\_\_\_ ft. to \_\_\_\_\_ ft.

What is the nearest source of possible contamination:  
 1 Septic tank     4 Lateral lines     7 Pit privy     10 Livestock pens     14 Abandoned water well  
 2 Sewer lines     5 Cess pool     8 Sewage lagoon     11 Fuel storage     15 Oil well/Gas well  
 3 Watertight sewer lines     6 Seepage pit     9 Feedyard     12 Fertilizer storage     16 Other (specify below)  
 \_\_\_\_\_     \_\_\_\_\_     \_\_\_\_\_     \_\_\_\_\_    None observed

Direction from well? \_\_\_\_\_ How many feet? \_\_\_\_\_

FROM	TO	LITHOLOGIC LOG	FROM	TO	PLUGGING INTERVALS
0	12	Fine Sand			
12	18	Caliche			
18	180	Sandy clay & sand strks			
180	320	Sand med to coarse			
320	435	Sand med to Cr. & Clay stricks			

7 CONTRACTOR'S OR LANDOWNER'S CERTIFICATION: This water well was (1) constructed, (2) reconstructed, or (3) plugged under my jurisdiction and was completed on (mo/day/year) 7-14/06 and this record is true to the best of my knowledge and belief. Kansas Water Well Contractor's Licence No 435 This Water Well Record was completed on (mo/day/yr) 7/14/06 under the business name of Taylor Water Well Inc by (signature) Doug Titus