


LOCATION OF WATER WELL: County: Stevens Fraction: NW 1/4 NW 1/4 SE 1/4 Section Number: 34 Township Number: T 32 S Range Number: R 38 E W

Distance and direction from nearest town or city street address of well if located within city?
4 West 2 1/2 North 1/2 West OF HUGOTON

2 WATER WELL OWNER: Pelajo Properties
 RR#, St. Address, Box #: %Mary Alice Owens Board of Agriculture, Division of Water Resources
 City, State, ZIP Code: 6104 Copperhill DR. Dallas Tx. 75248 Application Number:

3 LOCATE WELL'S LOCATION WITH AN "X" IN SECTION BOX:

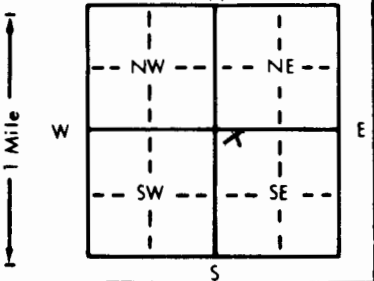

4 DEPTH OF COMPLETED WELL: 52.7 ft. ELEVATION:
 Depth(s) Groundwater Encountered 1. 18.2 ft. 2. ft. 3. ft.
 WELL'S STATIC WATER LEVEL: 18.2 ft. below land surface measured on mo/day/yr
 Pump test data: Well water was NA ft. after hours pumping gpm
 Est. Yield 2500 gpm: Well water was ft. after hours pumping gpm
 Bore Hole Diameter: 24 in. to ft., and in. to ft.
 WELL WATER TO BE USED AS:
 1 Domestic 3 Feedlot 6 Oil field water supply 9 Dewatering 12 Other (Specify below)
 2 Irrigation 4 Industrial 7 Lawn and garden only 10 Monitoring well
 Was a chemical/bacteriological sample submitted to Department? Yes No If yes, mo/day/yr sample was submitted
 Water Well Disinfected? Yes No

5 TYPE OF BLANK CASING USED:
 1 Steel 3 RMP (SR) 5 Wrought iron 8 Concrete tile CASING JOINTS: Glued Clamped
 2 PVC 4 ABS 6 Asbestos-Cement 9 Other (specify below) Welded
 7 Fiberglass Threaded

Blank casing diameter: 16 in. to 52.7 ft. Dia. in. to ft. Dia. in. to ft.
 Casing height above land surface: 17 in. weight: 36.91 lbs./ft. Wall thickness or gauge No. 219

TYPE OF SCREEN OR PERFORATION MATERIAL:
 1 Steel 3 Stainless steel 5 Fiberglass 7 PVC 10 Asbestos-cement
 2 Brass 4 Galvanized steel 6 Concrete tile 8 RMP (SR) 11 Other (specify)
 12 None used (open hole)

SCREEN OR PERFORATION OPENINGS ARE:
 1 Continuous slot 3 Mill slot 5 Gauzed wrapped 8 Saw cut 11 None (open hole)
 2 Louvered shutter 4 Key punched 6 Wire wrapped 9 Drilled holes
 7 Torch cut 10 Other (specify)

SCREEN-PERFORATED INTERVALS: From 40.7 ft. to 52.7 ft., From 24.7 ft. to 32.7 ft.
 GRAVEL PACK INTERVALS: From 20 ft. to 52.7 ft., From ft. to ft.

6 GROUT MATERIAL: 1 Neat cement 2 Cement grout 3 Bentonite 4 Other
 Grout Intervals: From ft. to ft., From ft. to ft., From ft. to ft.

What is the nearest source of possible contamination:
 1 Septic tank 4 Lateral lines 7 Pit privy 10 Livestock pens 14 Abandoned water well
 2 Sewer lines 5 Cess pool 8 Sewage lagoon 11 Fuel storage 15 Oil well/Gas well
 3 Watertight sewer lines 6 Seepage pit 9 Feedyard 12 Fertilizer storage 16 Other (specify below)
 13 Insecticide storage

Direction from well? 300' West How many feet? 300'

| FROM | TO | LITHOLOGIC LOG | FROM | TO | PLUGGING INTERVALS |
|------|-----|--------------------------------|------|-----|--------------------|
| 0 | 2 | Surface | 525 | 530 | Red bed |
| 2 | 20 | Fine sand | | | |
| 20 | 42 | Coarse sand | | | |
| 42 | 68 | Med sand | | | |
| 68 | 170 | Brown clay/hard lime shell | | | |
| 170 | 225 | Gray & brown clay w/rock shell | | | |
| 225 | 255 | Coarse sand 30' | | | |
| 255 | 267 | Clay w/small sand strips | | | |
| 267 | 308 | Coarse sand & gravel 41' | | | |
| 308 | 312 | Clay | | | |
| 312 | 327 | Sandrock 15' | | | |
| 327 | 336 | Brown clay | | | |
| 336 | 400 | Sandstone & sandrock 50% 32' | | | |
| 400 | 440 | Sandrock 75% 30' | | | |
| 440 | 525 | Sandrock 50% 42' | | | |

7 CONTRACTOR'S OR LANDOWNER'S CERTIFICATION: This water well was (1) constructed, (2) reconstructed, or (3) plugged under my jurisdiction and was completed on (mo/day/year) Sept. 9, 1998 and this record is true to the best of my knowledge and belief. Kansas Water Well Contractor's License No. 164 This Water Well Record was completed on (mo/day/yr) under the business name of Houck Bros. Drilling by (signature) Gerald Houck