


USE TYPEWRITER OR BALL POINT PEN-PRESS FIRMLY, PRINT CLEARLY.

WATER WELL RECORD  
KSA 82a-1201-1215

Kansas Department of Health and Environment-Division of Environment  
(Water well Contractors)  
Topeka, Kansas 66620

1. Location of well: County Stevens Fraction NE 1/4 NE 1/4 SE 1/4 Section number 5 Township number T 32 S Range number R 38 E/W

2. Distance and direction from nearest town or city: 13 1/2 NW 3. Owner of well: MURIEL CURTIS  
Street address of well location if in city: HUGOTON, KA. R.R. or street: R- B.  
City, state, zip code: HUGOTON, Kansas 67851

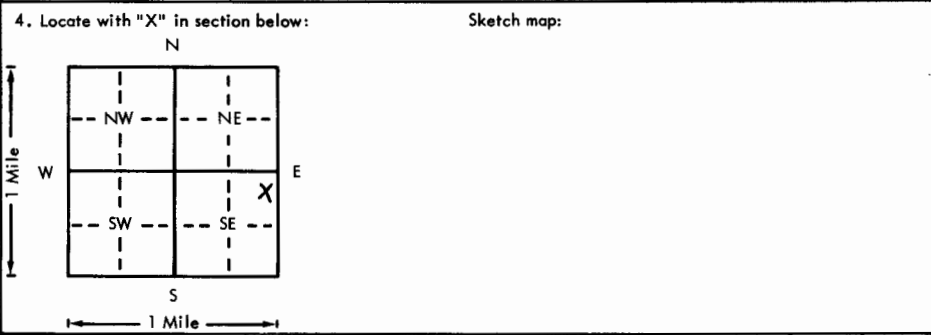

6. Bore hole dia. 10 in. Completion date 10-11-76  
Well depth 200 ft.

7. Cable tool  Rotary  Driven  Dug  
 Hollow rod  Jetted  Bored  Reverse rotary

8. Use:  Domestic  Public supply  Industry  
 Irrigation  Air conditioning  Stock  
 Lawn  Oil field water  Other

9. Casing: Material  Height: Above or below  
Threaded  Welded  Surface 24 in.  
RMP  PVC Sch 40 Weight  lbs./ft.  
Dia. 5 in. to 200 ft. depth Wall Thickness: inches or  
Dia.  in. to  ft. depth gage No. .250

5. Type and color of material	From	To
Sandy silt Gray	0	4'
Tan silt	4	12
Clay Tan w/ calcareous nodules	12	25
" " + brown joint clays	25	60
Clay balls w/ gravel redish	60	68
" " w/ some gravel-redish sand	68	100
" " + shaley clay	100	108
" " w/ gravel-jip + sand	108	128
Clays tan	128	178
Clay balls w/ some sand (loose)	178	186
Clay shelves w/ sand layers intermittently	186	196
Clay ball w/ fine sand (tan)	196	200
(Use a second sheet if needed)		

10. Screen: Manufacturer's name Sloam  
Type Saw cut Dia. 5"  
Slot/gauze 1/8 Length 90'  
Set between 108 ft. and 128 ft.  
180 ft. and 200 ft.  
Gravel pack?  Size range of material 1/8-1/4

11. Static water level:  mo./day/yr.  
80 ft. below land surface Date 10-11-76

12. Pumping level below land surfaces:  
90 ft. after 1 hrs. pumping 10 g.p.m.  
 ft. after  hrs. pumping  g.p.m.  
Estimated maximum yield 60 g.p.m.

13. Water sample submitted:  mo./day/yr.  
Yes  No Date

14. Well head completion: well seal  
 Pitless adapter  inches above grade

15. Well grouted?   
With:  Neat cement  Bentonite  Concrete  
Depth: From 0 ft. to 10 ft.

16. Nearest source of possible contamination: ?  
ft.  Direction  Type   
Well disinfected upon completion?  Yes  No

17. Pump:  Not installed  
Manufacturer's name Pum P Co  
Model number 525513 HP 1/2 Volts 330  
Length of drop pipe 140 ft. capacity 10 g.p.m.  
Type:  
 Submersible  Turbine  
 Jet  Reciprocating  
 Centrifugal  Other

18. Elevation: Topography:  Hill  Slope  Upland  Valley

19. Remarks:

20. Water well contractor's certification:  
This well was drilled under my jurisdiction and this report is true to the best of my knowledge and belief.  
Sloam Drilling 127  
Business name License No.  
Address HUGOTON, Kansas  
Signed Paul Sloam Date 10-13-  
Authorized representative

3238 W 5 NENESE 1/4 1/4 2/14