

USE TYPEWRITER OR BALL POINT PEN—PRESS FIRMLY, PRINT CLEARLY.


WATER WELL RECORD
KSA 82a-1201-1215

Kansas Department of Health and Environment—Division of Environment
(Water well Contractors)
Topeka, Kansas 66620

CWV Inv. #12802

1. Location of well: County Stevens Tracton SW/4 NE-1/4 SE 1/4 Section number 6 Township number T 32 S Range number R 38 E/W

2. Distance and direction from nearest town or city: From Hugoton Go 3 mi. No. on Hwy. #270 to Moscow Rd. then 6 mi. We. 2 mi. So. 2 mi. We. & north into location
3. Owner of well: Anadarko Production Co.
R.R. or street: c/o Paul Gatlin, P.O. Box 351
City, state, zip code: Liberal, Kansas 67901

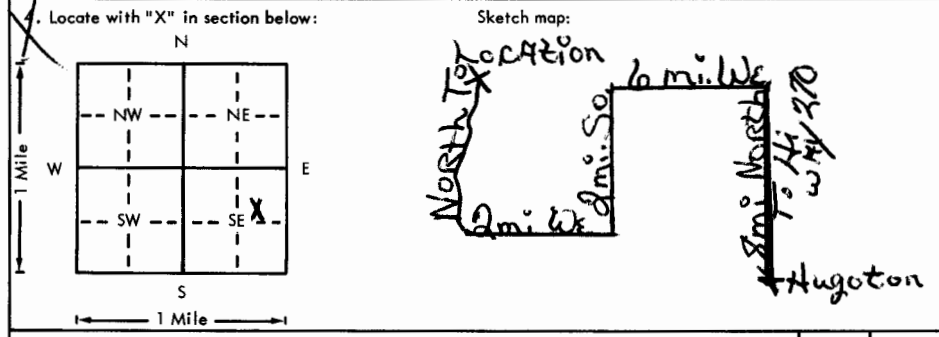

6. Bore hole dia. 9 in. Completion date 10/22/76
Well depth 240
7. Cable tool Rotary Driven Dug
 Hollow rod Jetted Bored Reverse rotary
8. Use: Domestic Public supply Industry
 Irrigation Air conditioning Stock
 Lawn Oil field water Other
9. Casing: Material Height: Above or below
Threaded Welded Surface 28 in.
RMP PVC Weight 2, 73 lbs./ft.
Dia. 5 in. to 155 ft. depth Wall Thickness: inches or
Dia. 5 in. to 240 ft. depth gauge No. 265

5. Type and color of material	From	To
Surface	0	2
Sandy Clay	2	60
Fine & med. sand	60	80
Med. to lge. sand & sandy clay	80	100
Fine & med. sand & sandy clay	100	160
Fine & med. sand & sandy clay	160	240

10. Screen: Manufacturer's name Saved Perf.
Type PVC Dia. 5"
Slot/gauze .030 Length 80'
Set between 155 ft. and 235 ft.
 ft. and ft.
Gravel pack? yes Size range of material 1/8-3/16
11. Static water level: 90 ft. below land surface Date 10/22/76 mo./day/yr.
12. Pumping level below land surfaces:
 ft. after hrs. pumping g.p.m.
 ft. after hrs. pumping g.p.m.
Estimated maximum yield 60 g.p.m.
13. Water sample submitted: mo./day/yr.
 Yes No Date
14. Well head completion:
 Pitless adapter 28 inches above grade
15. Well grouted? yes
With: Neat cement Bentonite Concrete
Depth: From 0 ft. to 10 ft.
16. Nearest source of possible contamination:
ft. 100 Direction NE Type oilfield
Well disinfected upon completion? Yes No
17. Pump: Not installed
Manufacturer's name
Model number HP Volts
Length of drop pipe ft. capacity g.p.m.
Type:
 Submersible Turbine
 Jet Reciprocating
 Centrifugal Other

18. Elevation: _____
19. Remarks:

Topography:
 Hill
 Slope
 Upland
 Valley

20. Water well contractor's certification:
This well was drilled under my jurisdiction and this report is true to the best of my knowledge and belief.
Carlile Water Well 118
Business name _____ License No. _____
Address Box 275 Liberal, KS
Signed Edward E. Meam Date 11/7
Authorized representative

32
380
W
Sec
1/4 1/4 3/4