


USE TYPEWRITER OR BALL POINT PEN-PRESS FIRMLY, PRINT CLEARLY.

WATER WELL RECORD  
KSA 82a-1201-1215

Kansas Department of Health and Environment-Division of Environment (Water well Contractors) Topeka, Kansas 66620

1. Location of well:	County <b>Stevens</b>	Fraction <b>NW 1/4 NW 1/4 SW 1/4</b>	Section number <b>11</b>	Township number <b>T 32 S R 38 E/W</b>	Range number <b>38</b>
----------------------	--------------------------	---	-----------------------------	---	---------------------------

2. Distance and direction from nearest town or city: <b>19 miles south, 3 west, 2 south, 2 west, 1/2 south of Ulysses, Ks.</b>	3. Owner of well: <b>Walter Hittle</b> R.R. or street: <b>Star Route #2</b> City, state, zip code: <b>Hugoton, Ks. 67901</b>
---	---

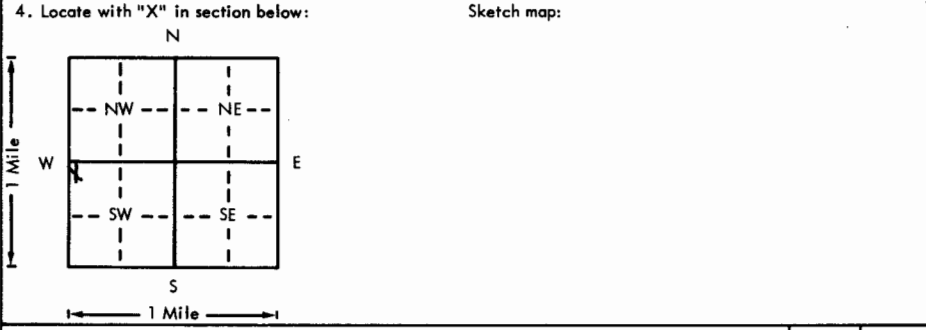

6. Bore hole dia. 27 in. Completion date This  
Well depth 475 ft. well has not been completely paid for

7.  Cable tool  Rotary  Driven  Dug  
 Hollow rod  Jetted  Bored  Reverse rotary

8. Use:  Domestic  Public supply  Industry  
 Irrigation  Air conditioning  Stock  
 Lawn  Oil field water  Other

9. Casing: Material steel Height Above or below  
Threaded  Welded  Surface 14 in.  
RMP  PVC  Weight 36.8 lbs./ft.  
Dia. 16 in. to 238.5 depth Wall Thickness: inches or  
Dia.     in. to     ft. depth gage No. .219

5. Type and color of material	From	To
<u>Surface</u>	<u>0</u>	<u>2</u>
<u>Very fine to fine sand w/clay breakers</u>	<u>2</u>	<u>27</u>
<u>Sandy clay, lime shale &amp; very fine sand strips</u>	<u>27</u>	<u>49</u>
<u>Fine to medium sand w/clay breakers</u>	<u>49</u>	<u>84</u>
<u>Medium to coarse sand &amp; gravel</u>	<u>84</u>	<u>106</u>
<u>Brown sandy clay w/lime shale and very fine sand</u>	<u>106</u>	<u>223</u>
<u>Very fine to medium sand w/clay breakers</u>	<u>223</u>	<u>242</u>
<u>Sandy clay w/very fine sand strips</u>	<u>242</u>	<u>251</u>
<u>Very fine to medium w/coarse sand w/clay breakers</u>	<u>251</u>	<u>315</u>
<u>Very fine to fine sand w/clay breakers</u>	<u>315</u>	<u>332</u>
<u>Very fine to medium and coarse sand w/clay breakers</u>	<u>332</u>	<u>345</u>
<u>Very fine to fine sand w/clay breakers</u>	<u>345</u>	<u>364</u>
<u>Fine to coarse sand w/clay breakers</u>	<u>364</u>	<u>390</u>
<u>Very fine to fine sand w/clay breakers</u>	<u>390</u>	<u>424</u>
<u>Very fine to medium and coarse sand w/clay breakers</u>	<u>424</u>	<u>435</u>
<u>Very fine sand w/clay breakers</u>	<u>435</u>	<u>468</u>
<u>Red bed</u>	<u>468</u>	<u>475</u>

10. Screen: Manufacturer's name Lakewood  
Pipe of Texas  
Type steel Dia. 16"  
Slot/gauze 3/16 Length 116.7'  
Set between 238.5 ft. and 315 ft.  
435 ft. and 475 ft.  
Gravel pack?  Size range of material 1/2 x 5/8"

11. Static water level: 147.4 ft. below land surface Date 8-30-76 mo./day/yr.

12. Pumping level below land surfaces:  
357 ft. after 65.6 hrs. pumping 927 g.p.m.  
    ft. after     hrs. pumping     g.p.m.  
Estimated maximum yield 1000 g.p.m.

13. Water sample submitted:     mo./day/yr.  
 Yes  No Date    

14. Well head completion: NA  
 Pitless adapter     Inches above grade

15. Well grouted?   
With:  Neat cement  Bentonite  Concrete  
Depth: From 0 ft. to 10 ft.

16. Nearest source of possible contamination:  
ft.     Direction     Type NA  
Well disinfected upon completion?  Yes  No

17. Pump:  Not installed  
Manufacturer's name      
Model number     HP     Volts      
Length of drop pipe     ft. capacity     g.p.m.  
Type:  
 Submersible  Turbine  
 Jet  Reciprocating  
 Centrifugal  Other

18. Elevation: \_\_\_\_\_

19. Remarks:  
**W. A. Brown FreeFlo Perforation set between 315 and 435 feet =**

Topography:  
 Hill  
 Slope  
 Upland  
 Valley

20. Water well contractor's certification:  
This well was drilled under my jurisdiction and this report is true to the best of my knowledge and belief.  
**Houck Bros. Drig. Co. 164**

Business name     License No.      
Address Box 487, Ulysses, Ks.  
Signed M. Beard Date 11/3/76  
Authorized representative

32 38 W 11 1/4 1/4 9/14 Sec