


1 LOCATION OF WATER WELL: County: **Stevens** Fraction: **S 1/2 1/4 S 1/2 1/4 NE 1/4** Section Number: **24** Township Number: **T 32 S** Range Number: **R 38 E (W)**

Distance and direction from nearest town or city street address of well if located within city? **From the elevators in Hugoton go 3 mi West 5 mi North 1/2 mi East 1/2 mi South 1/2 mi East and South to location.**

2 WATER WELL OWNER: **Walter Beasley Lanex Drilling**
 RR#, St. Address, Box #: **117 South Monroe Mobil Oil Corp.**
 City, State, ZIP Code: **Hugoton**
 Board of Agriculture, Division of Water Resources
 Application Number: **T 84-125**

3 LOCATE WELL'S LOCATION WITH AN "X" IN SECTION BOX:

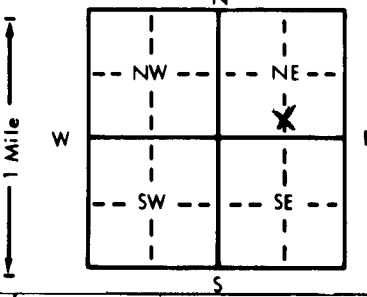

4 DEPTH OF COMPLETED WELL: **320** ft. ELEVATION: _____ ft.
 Depth(s) Groundwater Encountered 1. **194** ft. 2. _____ ft. 3. _____ ft.
 WELL'S STATIC WATER LEVEL: **126** ft. below land surface measured on mo/day/yr **3/11/84**
 Pump test data: Well water was _____ ft. after _____ hours pumping _____ gpm
 Est. Yield **60** gpm: Well water was _____ ft. after _____ hours pumping _____ gpm
 Bore Hole Diameter: **11** in. to **320** ft., and _____ in. to _____ ft.
 WELL WATER TO BE USED AS:
 1 Domestic 3 Feedlot 6 Oil field water supply 9 Dewatering 12 Other (Specify below)
 2 Irrigation 4 Industrial 7 Lawn and garden only 10 Observation well
 Was a chemical/bacteriological sample submitted to Department? Yes _____ No _____; If yes, mo/day/yr sample was submitted _____
 Water Well Disinfected? Yes _____ No _____

5 TYPE OF BLANK CASING USED:
 1 Steel 3 RMP (SR) 5 Wrought iron 8 Concrete tile CASING JOINTS: Glued _____ Clamped _____
2 PVC 4 ABS 6 Asbestos-Cement 9 Other (specify below) Welded _____
 7 Fiberglass Threaded _____
 Blank casing diameter **6** in. to **240** ft., Dia. _____ in. to _____ ft., Dia. _____ in. to **265** ft.
 Casing height above land surface: **285** in., weight **285** lbs./ft. Wall thickness or gauge No. _____
 TYPE OF SCREEN OR PERFORATION MATERIAL:
 1 Steel 3 Stainless steel 5 Fiberglass 8 PVC 10 Asbestos-cement
 2 Brass 4 Galvanized steel 6 Concrete tile 9 ABS 11 Other (specify) _____
 12 None used (open hole)
 SCREEN OR PERFORATION OPENINGS ARE:
 1 Continuous slot 3 Mill slot 5 Gauzed wrapped 8 Saw cut 11 None (open hole)
 2 Louvered shutter 4 Key punched 6 Wire wrapped 9 Drilled holes
 7 Torch cut 10 Other (specify) _____
 SCREEN-PERFORATED INTERVALS: From **240** ft. to **320** ft., From _____ ft. to _____ ft.
 From _____ ft. to _____ ft., From _____ ft. to _____ ft.
 GRAVEL PACK INTERVALS: From **13** ft. to **116** ft., From **126** ft. to **320** ft.
 From _____ ft. to _____ ft., From _____ ft. to _____ ft.

6 GROUT MATERIAL: 1 Neat cement 2 Cement grout 3 Bentonite 4 Other
 Grout Intervals: From **3** ft. to **13** ft., From **116** ft. to **126** ft., From _____ ft. to _____ ft.
 What is the nearest source of possible contamination:
 1 Septic tank 4 Lateral lines 7 Pit privy 10 Livestock pens 14 Abandoned water well
 2 Sewer lines 5 Cess pool 8 Sewage lagoon 11 Fuel storage 15 Oil well/Gas well
 3 Watertight sewer lines 6 Seepage pit 9 Feedyard 12 Fertilizer storage 16 Other (specify below)
 13 Insecticide storage
 Direction from well? **Northeast** How many feet? **100'**

| FROM | TO | LITHOLOGIC LOG | FROM | TO | LITHOLOGIC LOG |
|------------|------------|------------------------------------|------|----|----------------|
| | | Log for plugging water well | | | |
| 0 | 3 | dirt | | | |
| 3 | 13 | cement | | | |
| 13 | 116 | sand | | | |
| 116 | 126 | cement | | | |
| 126 | 320 | sand | | | |

7 CONTRACTOR'S OR LANDOWNER'S CERTIFICATION: This water well was (1) constructed, (2) reconstructed, or (3) plugged under my jurisdiction and was completed on (mo/day/year) **February 25, 1984** and this record is true to the best of my knowledge and belief. Kansas Water Well Contractor's License No. **118**. This Water Well Record was completed on (mo/day/yr) **April 13, 1987** under the business name of **Carlile Water Well Service, Inc.** by (signature) *[Signature]*

OFFICE USE ONLY