


1 LOCATION OF WATER WELL:	Fraction	Section Number	Township Number	Range Number
County: Stevens	SE ¼ NW ¼ NW ¼	26	T 32 S	R 38 EW

Distance and direction from nearest town or city street address of well if located within city? From Hugoton, KS 4 Mi. West on Blacktop Road, 3 ½ Mi. North, ½ Mi. East into location.

2 WATER WELL OWNER: Warren Moon
 RR#, St. Address, Box #: HC - 01
 City, State, ZIP Code: Hugoton, KS 67950

Mobil Oil Corp.
 Board of Agriculture, Division of Water Resources
 Application Number: T89-337

3 LOCATE WELL'S LOCATION WITH AN "X" IN SECTION BOX:

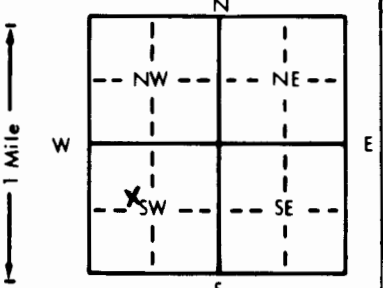

4 DEPTH OF COMPLETED WELL: 320 ft. ELEVATION:

Depth(s) Groundwater Encountered 1. _____ ft. 2. _____ ft. 3. _____ ft.

WELL'S STATIC WATER LEVEL: 152 ft. below land surface measured on mo/day/yr 7-26-89

Pump test data: Well water was _____ ft. after _____ hours pumping _____ gpm

Est. Yield _____ gpm: Well water was _____ ft. after _____ hours pumping _____ gpm

Bore Hole Diameter: 9 in. to 320 ft., and _____ in. to _____ ft.

WELL WATER TO BE USED AS:

1 Domestic	3 Feedlot	6 Oil field water supply	9 Dewatering
2 Irrigation	4 Industrial	7 Lawn and garden only	10 Monitoring well
5 Public water supply	8 Air conditioning	11 Injection well	12 Other (Specify below)

Was a chemical/bacteriological sample submitted to Department? Yes _____ No If yes, mo/day/yr sample was submitted _____

Water Well Disinfected? Yes No

5 TYPE OF BLANK CASING USED:

1 Steel	3 RMP (SR)	5 Wrought iron	8 Concrete tile	CASING JOINTS: Glued <input checked="" type="checkbox"/> Clamped _____
2 PVC	4 ABS	6 Asbestos-Cement	9 Other (specify below)	Welded _____
Blank casing diameter: 5.563 in. to 200 ft., Dia _____ in. to _____ ft., Dia _____ in. to _____ ft.	7 Fiberglass			Threaded _____
Casing height above land surface: 24 in., weight 2.93 lbs./ft. Wall thickness or gauge No. .265				

TYPE OF SCREEN OR PERFORATION MATERIAL:

1 Steel	3 Stainless steel	5 Fiberglass	8 RMP (SR)	11 Other (specify) _____
2 Brass	4 Galvanized steel	6 Concrete tile	9 ABS	12 None used (open hole)

SCREEN OR PERFORATION OPENINGS ARE:

1 Continuous slot	3 Mill slot	5 Gauzed wrapped	8 Saw cut	11 None (open hole)
2 Louvered shutter	4 Key punched	6 Wire wrapped	9 Drilled holes	
		7 Torch cut	10 Other (specify) _____	

SCREEN-PERFORATED INTERVALS: From 200 ft. to 320 ft., From _____ ft. to _____ ft.

GRAVEL PACK INTERVALS: From 21 ft. to 180 ft., From 190 ft. to 320 ft.

6 GROUT MATERIAL: 1 Neat cement 2 Cement grout 3 Bentonite 4 Other _____

Grout Intervals: From 0 ft. to 2 ft., From 2 ft. to 21 ft., From 180 ft. to 190 ft.

What is the nearest source of possible contamination:

1 Septic tank	4 Lateral lines	7 Pit privy	10 Livestock pens	14 Abandoned water well
2 Sewer lines	5 Cess pool	8 Sewage lagoon	11 Fuel storage	15 Oil well/Gas well
3 Watertight sewer lines	6 Seepage pit	9 Feedyard	12 Fertilizer storage	16 Other (specify below)
			13 Insecticide storage	

Direction from well? Southwest How many feet? 580'

FROM	TO	LITHOLOGIC LOG	FROM	TO	PLUGGING INTERVALS
0	2	Surface			
2	44	90% Clay, 10% Tan sandy clay.			
44	75	70% Clay, 30% Tan sandy clay.			
75	90	30% Clay, 70% Fine sand.			
90	125	50% Clay, 10% med/lrg sand, 20% white sandy clay.			
125	140	50% Clay, 50% Tan Sandy Clay.			
140	190	70% Clay, 30% Red-Tan Sandy clay.			
190	210	10% Clay, 70% med/lrg sand, 20% sandy clay.			
210	270	Med/lrg Sand.			
270	300	10% Clay, 40% med/lrg sand, 40% Fine sand, 10% Sandy Clay.			
300	320	40% Clay, 40% med/lrg sand, 20% Sandy clay.			

7 CONTRACTOR'S OR LANDOWNER'S CERTIFICATION: This water well was (1) constructed, (2) reconstructed, or (3) plugged under my jurisdiction and was completed on (mo/day/year) 7-26-89 and this record is true to the best of my knowledge and belief. Kansas Water Well Contractor's License No. 118. This Water Well Record was completed on (mo/day/yr) 8-3-89 under the business name of Carlile Water Well Service, Inc. by (signature)