


1 LOCATION OF WATER WELL: County: Stevens Fraction: SW 1/4 NW 1/4 SE 1/4 Section Number: 29 Township Number: T 32 S Range Number: R 38 E W

Distance and direction from nearest town or city street address of well if located within city?
 From Feterita: 4N, 1E, 1N 1/4 W & N into--

2 WATER WELL OWNER: Dave Bozone
 RR#, St. Address, Box #: HC-02 Board of Agriculture, Division of Water Resources
 City, State, ZIP Code: Rolla, KS 67954 Application Number:

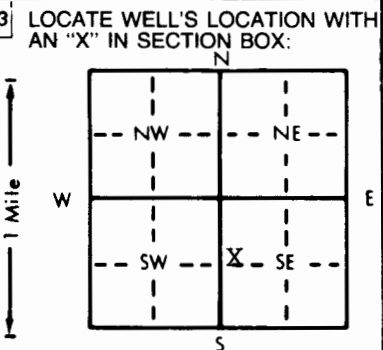

4 DEPTH OF COMPLETED WELL: 400 ft. ELEVATION: _____
 Depth(s) Groundwater Encountered 1. 160 ft. 2. _____ ft. 3. _____ ft.
 WELL'S STATIC WATER LEVEL 160 ft. below land surface measured on mo/day/yr 4/28/93
 Pump test data: Well water was 330 ft. after 1 hours pumping 60 gpm
 Est. Yield 60 gpm: Well water was _____ ft. after _____ hours pumping _____ gpm
 Bore Hole Diameter: 9 1/2 in. to 400 ft., and _____ in. to _____ ft.
 WELL WATER TO BE USED AS:
 1 Domestic 3 Feedlot 6 Oil field water supply 9 Dewatering 12 Other (Specify below)
 2 Irrigation 4 Industrial 7 Lawn and garden only 10 Monitoring well
 Was a chemical/bacteriological sample submitted to Department? Yes _____ No X; If yes, mo/day/yr sample was submitted _____
 Water Well Disinfected? Yes X No _____

5 TYPE OF BLANK CASING USED:
 1 Steel 3 RMP (SR) 5 Wrought iron 8 Concrete tile CASING JOINTS: Glued X Clamped _____
 2 PVC 4 ABS 6 Asbestos-Cement 9 Other (specify below) Welded _____
 _____ _____ 7 Fiberglass _____ Threaded _____
 Blank casing diameter 5 in. to 400 ft., Dia _____ in. to _____ ft., Dia _____ in. to _____ ft.
 Casing height above land surface 24 in., weight 2.902 lbs./ft. Wall thickness or gauge No. 280 SDR21
 TYPE OF SCREEN OR PERFORATION MATERIAL:
 1 Steel 3 Stainless steel 5 Fiberglass 7 PVC 10 Asbestos-cement
 2 Brass 4 Galvanized steel 6 Concrete tile 8 RMP (SR) 11 Other (specify) _____
 _____ _____ _____ 9 ABS 12 None used (open hole)
 SCREEN OR PERFORATION OPENINGS ARE:
 1 Continuous slot 3 Mill slot 5 Gauzed wrapped 8 Saw cut 11 None (open hole)
 2 Louvered shutter 4 Key punched 6 Wire wrapped 9 Drilled holes
 _____ _____ 7 Torch cut 10 Other (specify) _____
 SCREEN-PERFORATED INTERVALS: From 310 ft. to 390 ft., From 220 ft. to 400 ft.
 From _____ ft. to _____ ft., From of SDR17 .375ft. to wall thickness ft.
 GRAVEL PACK INTERVALS: From 200 ft. to 400 ft., From 3.539ft. to lbs/ft.
 From _____ ft. to _____ ft., From _____ ft. to _____ ft.

6 GROUT MATERIAL: 1 Neat cement 2 Cement grout 3 Bentonite 4 Other Hole Plug
 Grout Intervals: From 1 ft. to 20 ft., From _____ ft. to _____ ft., From _____ ft. to _____ ft.
 What is the nearest source of possible contamination:
 1 Septic tank 4 Lateral lines 7 Pit privy 10 Livestock pens 14 Abandoned water well
 2 Sewer lines 5 Cess pool 8 Sewage lagoon 11 Fuel storage 15 Oil well/Gas well
 3 Watertight sewer lines 6 Seepage pit 9 Feedyard 12 Fertilizer storage 16 Other (specify below)
 _____ _____ _____ 13 Insecticide storage
 Direction from well? _____ How many feet? _____

FROM	TO	LITHOLOGIC LOG	FROM	TO	PLUGGING INTERVALS
0	2	Surface Soil			
2	17	Sandy Clay			
17	30	Clay			
30	89	Sandy Clay			
89	95	Sand & Gravel			
95	124	Clay			
124	150	Sandy Clay			
150	165	Sand			
165	197	Sandy Clay			
197	354	Clay			
354	400	Sand			

7 CONTRACTOR'S OR LANDOWNER'S CERTIFICATION: This water well was (1) constructed, (2) reconstructed, or (3) plugged under my jurisdiction and was completed on (mo/day/year) 4/28/93 and this record is true to the best of my knowledge and belief. Kansas Water Well Contractor's License No. KWWCL-430 This Water Well Record was completed on (mo/day/yr) 4/28/93 under the business name of Howard Drlg. Co. Box 806 Beaver, OK 73932 by (signature) _____

INSTRUCTIONS: Use typewriter or ball point pen. PLEASE PRESS FIRMLY and PRINT clearly. Please fill in blanks, underline or circle the correct answers. Send top three copies to Kansas Department of Health and Environment, Bureau of Water, Topeka, Kansas 66620-0001. Telephone: 913-296-5545. Send one to WATER WELL OWNER and retain one for your records.