


WATER WELL RECORD Form WWC-5 KSA 82a-1212

1 LOCATION OF WATER WELL: Fraction Section Number Township Number Range Number  
 COUNTY: STEVENS SE 1/4 SW 1/4 SW 1/4 22 T 32 S R 39 W

Distance and direction from nearest town or city street address of well if located within city?  
 FROM ROLLA - NORTH ON HIGHWAY 51 - 14 MILES

2 WATER WELL OWNER: JARVIS, KRITH  
 RR#, St. Address, Box #: HC 01 -- BOX 6 Board of Agriculture, Division of Water Resources  
 City, State, ZIP code: ROLLA, KS 67954- Application Number:

3 LOCATE WELL'S LOCATION WITH AN "X" IN SECTION BOX:

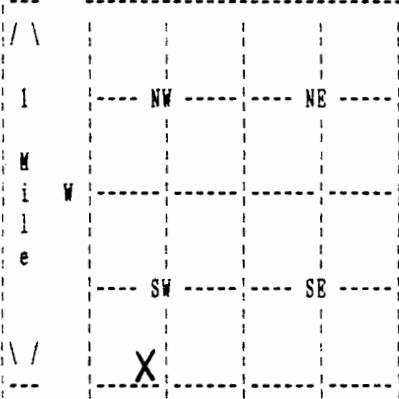

4 DEPTH OF COMPLETED WELL 205 ELEVATION: 0  
 Depth(s) Groundwater Encountered 1. 0 ft. 2. 0 ft. 3. 0 ft.

WELL'S STATIC WATER LEVEL 109 ft. below land surface measured on mo/day/yr 03/17/05  
 Pump test data: Well water was 0 ft. after 0 hours pumping 0 gpm

Estimated Yield 20 gpm: Well water was 0 ft. after 0 hours pumping 0 gpm

Bore Hole Diameter 10 in. to 205 ft., and in. to 0 ft.

WELL WATER TO BE USED AS: DOMESTIC

Was a chemical/bacteriological sample submitted to department? No ;  
 If yes, mo/day/yr sample was submitted Water well disinfected? Yes

5 TYPE OF BLANK CASING USED: PVC CASING JOINTS: GLUED  
 Blank casing diameter 5 in. to 205 ft., Dia in. to 0 ft., Dia in. to 0 ft.  
 Casing height above land surface 12 in., weight 200 lbs/ft. Wall thickness or gauge No. 21  
 TYPE OF SCREEN OR PERFORATION MATERIAL: PVC  
 SCREEN OR PERFORATION OPENINGS ARE: SAW CUT

SCREEN PERFORATED INTERVALS: From 180 ft. to 220 ft., From 0 ft. to 0 ft.  
 From 0 ft. to 0 ft., From 0 ft. to 0 ft.  
 GRAVEL PACK INTERVALS: From 20 ft. to 205 ft., From 0 ft. to 0 ft.  
 From 0 ft. to 0 ft., From 0 ft. to 0 ft.

6 GROUT MATERIAL BENTONITE  
 Grout Intervals: From 0 ft. to 20 ft., From 0 ft. to 0 ft., From 0 ft. to 0 ft.  
 What is the nearest source of possible contamination: NONE  
 Direction from well? How many feet? 0

FROM	TO	LITHOLOGIC LOG	FROM	TO	PLUGGING INTERVALS
0	20	01 TOPSOIL 02 FINE SAND 05 CLAY			
20	80	32 TAN CLAY			
80	100	32 TAN CLAY 35 CALACHIE			
100	140	32 TAN CLAY 35 CALACHIE 24 THINROCLAYER			
140	180	32 TAN CLAY 11 BROWN CLAY			
180	210	32 TAN CLAY 11 BROWN CLAY 29 SANDSTONE			
210	220	29 SANDSTONE 17 CLAY LAYERS			
220	230	05 CLAY 07 BLUE SHALE			

7 CONTRACTOR'S OR LANDOWNER'S CERTIFICATION: This water well was Constructed under my jurisdiction and was completed on (mo/day/year) 03/18/05 and this record is true to the best of my knowledge and belief. Kansas Water Well Contractor's License No. 179 This Water Well Record was completed on (mo/day/yr) 03/22/05 under the business name of JOB'S WELL SERVICE, INC. by (signature) *Quick Creek*