


WATER WELL RECORD Form WWC-5 KSA 82a-1212

1 LOCATION OF WATER WELL: County: Morton Fraction SW 1/4 NW 1/4 NE 1/4 Section Number 8 Township Number T 32 S Range Number R 39 E/W

Distance and direction from nearest town or city street address of well if located within city? From Dermont School 3 South 1/2 East 1/4 South East into

2 WATER WELL OWNER: Renshaw B#3 OXY USA INC RR#, St. Address, Box #: Box 26100 Board of Agriculture, Division of Water Resources City, State, ZIP Code: Oklahoma City, OK 73126 Application Number: 900284

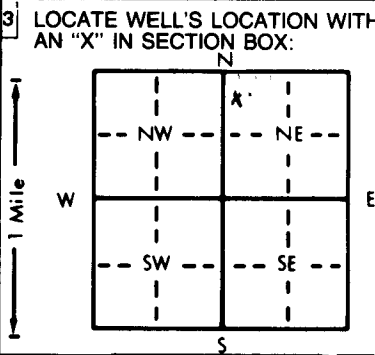

3 LOCATE WELL'S LOCATION WITH AN 'X' IN SECTION BOX: 4 DEPTH OF COMPLETED WELL: 305 ft. ELEVATION: 910.294 ft. WELL'S STATIC WATER LEVEL: 195 ft. below land surface measured on mo/day/yr 7-3-91

5 TYPE OF BLANK CASING USED: 1 Steel, 2 PVC, 3 RMP (SR), 4 ABS, 5 Wrought iron, 6 Asbestos-Cement, 7 Fiberglass, 8 Concrete tile, 9 Other (specify below), CASING JOINTS: Glued X, Clamped, Welded, Threaded. SCREEN OR PERFORATION MATERIAL: 1 Steel, 2 Brass, 3 Stainless steel, 4 Galvanized steel, 5 Fiberglass, 6 Concrete tile, 7 PVC, 8 RMP (SR), 9 ABS, 10 Asbestos-cement, 11 Other (specify), 12 None used (open hole).

6 GROUT MATERIAL: 1 Neat cement, 2 Cement grout, 3 Bentonite, 4 Other. Grout intervals: From 205 ft. to 305 ft. What is the nearest source of possible contamination: 1 Septic tank, 2 Sewer lines, 3 Watertight sewer lines, 4 Lateral lines, 5 Cess pool, 6 Seepage pit, 7 Pit privy, 8 Sewage lagoon, 9 Feedyard, 10 Livestock pens, 11 Fuel storage, 12 Fertilizer storage, 13 Insecticide storage, 14 Abandoned water well, 15 Oil well/Gas well, 16 Other (specify below).

Table with columns: FROM, TO, LITHOLOGIC LOG, FROM, TO, PLUGGING INTERVALS. Rows include: 0-195 Overburden, 195-220 Fine sand and clay, 220-240 Fine sand, sand stone and clay Lost circulation @ 240', 240-300 Sand stone and clay, 300-305 Sand stone, clay and blue shale.

7 CONTRACTOR'S OR LANDOWNER'S CERTIFICATION: This water well was (1) constructed, (2) reconstructed, or (3) plugged under my jurisdiction and was completed on (mo/day/year) 7-3-91 and this record is true to the best of my knowledge and belief. Kansas Water Well Contractor's License No. 142. This Water Well Record was completed on (mo/day/yr) 7-12-91 under the business name of T & W Water Well Service, Inc. by (signature) C. W. Wagemann