


1 LOCATION OF WATER WELL: Fraction C 1/4 NE 1/4 NE 1/4 Section Number 8 Township Number T 32 S Range Number R 39 EW

Distance and direction from nearest town or city street address of well if located within city?

11 miles East of Richfield--

2 WATER WELL OWNER: OXY USA, inc. #2 Renshaw 'C'
 RR#, St. Address, Box # : P. O. Box 26100 Board of Agriculture, Division of Water Resources
 City, State, ZIP Code : Oklahoma City, OK 73126-0100 Application Number: 910566

3 LOCATE WELL'S LOCATION WITH AN "X" IN SECTION BOX:

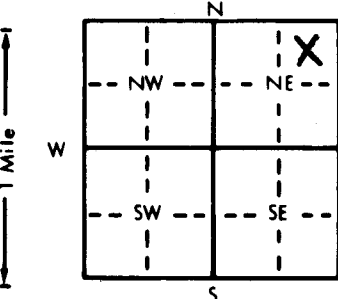

4 DEPTH OF COMPLETED WELL: 300 ft. ELEVATION: ft.
 Depth(s) Groundwater Encountered 1. 200 (200) ft. 2. ft. 3. ft.
 WELL'S STATIC WATER LEVEL 200 ft. below land surface measured on mo/day/yr 12/12/91
 Pump test data: Well water was 294 ft. after 1 hours pumping 100 gpm
 Est. Yield 100 gpm: Well water was ft. after hours pumping 100 gpm
 Bore Hole Diameter 11 in. to 300 ft., and in. to ft.
 WELL WATER TO BE USED AS: 5 Public water supply 8 Air conditioning 11 Injection well
 1 Domestic 3 Feedlot 6 Oil field water supply 9 Dewatering 12 Other (Specify below)
 2 Irrigation 4 Industrial 7 Lawn and garden only 10 Monitoring well
 Was a chemical/bacteriological sample submitted to Department? Yes..... No..... X..... If yes, mo/day/yr sample was sub-
 mitted Water Well Disinfected? Yes X No

5 TYPE OF BLANK CASING USED: 5 Wrought iron 8 Concrete tile CASING JOINTS: Glued X Clamped
 1 Steel 3 RMP (SR) 6 Asbestos-Cement 9 Other (specify below) Welded
 2 PVC 4 ABS 7 Fiberglass Threaded
 Blank casing diameter 6 in. to 300 ft., Dia in. to ft., Dia in. to ft.
 Casing height above land surface 24 in., weight lbs./ft. Wall thickness or gauge No. 032
 TYPE OF SCREEN OR PERFORATION MATERIAL: 7 PVC 10 Asbestos-cement
 1 Steel 3 Stainless steel 5 Fiberglass 8 RMP (SR) 11 Other (specify)
 2 Brass 4 Galvanized steel 6 Concrete tile 9 ABS 12 None used (open hole)
 SCREEN OR PERFORATION OPENINGS ARE: 5 Gauzed wrapped 8 Saw cut 11 None (open hole)
 1 Continuous slot 3 Mill slot 6 Wire wrapped 9 Drilled holes
 2 Louvered shutter 4 Key punched 7 Torch cut 10 Other (specify)
 SCREEN-PERFORATED INTERVALS: From 200 ft. to 300 ft., From ft. to ft.
 From ft. to ft., From ft. to ft.
 GRAVEL PACK INTERVALS: From 100 ft. to 300 ft., From ft. to ft.
 From ft. to ft., From ft. to ft.

6 GROUT MATERIAL: 1 Neat cement 2 Cement grout 3 Bentonite 4 Other Hole Plug
 Grout Intervals: From 1 ft. to 20 ft., From ft. to ft.
 What is the nearest source of possible contamination: 10 Livestock pens 14 Abandoned water well
 1 Septic tank 4 Lateral lines 7 Pit privy 11 Fuel storage 15 Oil well/Gas well
 2 Sewer lines 5 Cess pool 8 Sewage lagoon 12 Fertilizer storage 16 Other (specify below)
 3 Watertight sewer lines 6 Seepage pit 9 Feedyard 13 Insecticide storage
 Direction from well? Northwest How many feet? 250

FROM	TO	LITHOLOGIC LOG	FROM	TO	PLUGGING INTERVALS
0	1	Surface Soil			
1	65	Sandy Clay			
65	74	Sand			
74	143	Clay			
143	151	Sandy Clay			
151	169	Sand			
169	200	Sandy Clay			
200	230	Sand w/ Streaks of Clay			
230	254	Sand			
254	270	Sandstone			
270	290	Sand			
290	300	Blue Clay			

7 CONTRACTOR'S OR LANDOWNER'S CERTIFICATION: This water well was (1) constructed, (2) reconstructed, or (3) plugged under my jurisdiction and was completed on (mo/day/year) 12/12/91 and this record is true to the best of my knowledge and belief. Kansas Water Well Contractor's License No. KWWCL-430 This Water Well Record was completed on (mo/day/yr) 12/12/91 under the business name of Howard Drilling Co. Box 806 Beaver, OK 73932 (signature)

INSTRUCTIONS: Use typewriter or ball point pen. PLEASE PRESS FIRMLY and PRINT clearly. Please fill in blanks, underline or circle the correct answers. Send top three copies to Kansas Department of Health and Environment, Bureau of Water, Topeka, Kansas 66620-0001. Telephone: 913-296-5545. Send one to WATER WELL OWNER and retain one for your records.