


USE TYPEWRITER OR BALL POINT PEN-PRESS FIRMLY, PRINT CLEARLY.

WATER WELL RECORD  
KSA 82a-1201-1215

Kansas Department of Health and Environment-Division of Environment (Water well Contractors) Topeka, Kansas 66620

Location of well:  County: Stevens Fraction:  SW 1/4 NW 1/4 SE 1/4 Section number: 14 Township number: T 32 S R 39 Range number: 39  E/W

Distance and direction from nearest town or city: from east Hiway Jct. at Hugoton, Ks. 6 miles north -10 west Street address of well: Location 17 in city: 3. Owner of well: Charles Simmons R.R. or street: Big Bow, Kansas 67832 City, state, zip code:

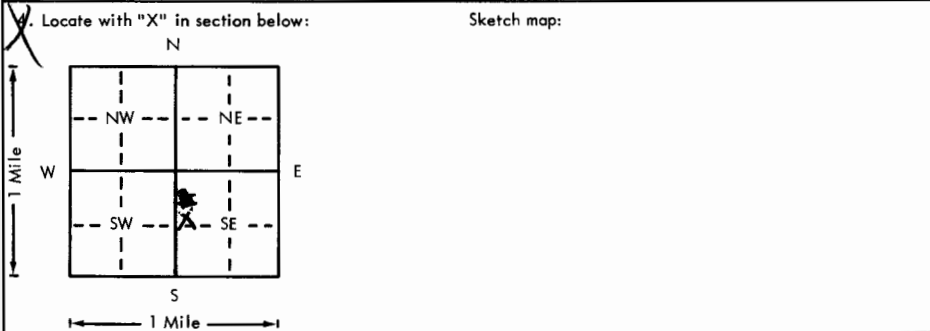

6. Bore hole dia. 9 3/4 in. Completion date: 5/20/77  
Well depth 135 ft.  
7. Cable tool  Rotary  Driven  Dug  
 Hollow rod  Jetted  Bored  Reverse rotary  
8. Use:  Domestic  Public supply  Industry  
 Irrigation  Air conditioning  Stock  
 Lawn  Oil field water  Other  
9. Casing: Material styrene Height:  Above or below  
Threaded  Welded  Surface 24 in.  
RMP  PVC glued Weight  lbs./ft.  
Dia. 5 in. to 135 ft. depth Wall Thickness: inches or  
Dia.  in. to  ft. depth gage No. 320

5. Type and color of material	From	To
Surface	0	2
Very fine sand & clay	2	23
Fine to coarse sand & gravel w/clay breakers	23	44
Brown sandy clay w/very fine sand strips	44	124
Fine to medium sand	124	135
(Use a second sheet if needed)		

10. Screen: Manufacturer's name Sunflower  
Type styrene Dia. 5"  
Slot/gauze 1/16" Length 40'  
Set between 95 ft. and 135 ft.  
 ft. and  ft.  
Gravel pack?  Size range of material 1/4 x 5/8"  
11. Static water level: 65 ft. below land surface Date 5/13/77 mo./day/yr.  
12. Pumping level below land surfaces:  
15 ft. after 3 hrs. pumping 5 g.p.m.  
 ft. after  hrs. pumping  g.p.m.  
Estimated maximum yield 15 g.p.m.  
13. Water sample submitted:  Yes  No Date  mo./day/yr.  
14. Well head completion:  
 Pitless adapter 24 Inches above grade  
15. Well grouted?  X  
With:  Neat cement  Bentonite  Concrete  
Depth: From 0 ft. to 10 ft.  
16. Nearest source of possible contamination:  
ft.  Direction  Type field  
Well disinfected upon completion?  Yes  No  
17. Pump:  X Not installed  
Manufacturer's name   
Model number  HP  Volts   
Length of drop pipe  ft. capacity  g.p.m.  
Type:  
 Submersible  Turbine  
 Jet  Reciprocating  
 Centrifugal  Other

18. Elevation: Topography:  Hill  Slope  Upland  Valley  
19. Remarks:

20. Water well contractor's certification:  
This well was drilled under my jurisdiction and this report is true to the best of my knowledge and belief.  
Houck Bros. Drilling Co. 164  
Business name License No. Box 487, Ulysses, Ks.  
Address  
Signed M. Beard Date 5/25/77  
Authorized representative

32 39 14 SUNWISE