


1 LOCATION OF WATER WELL:		Fraction				Section Number		Township Number		Range Number		
County:	Sumner	SE	¼	SW	¼	NE	¼	17	T 32	S	R 4	E(W)

Distance and direction from nearest town or city street address of well if located within city?
19' South of the North Side of Garfield St. and 104' West of the East Side of Sumpter St., Argonia, KS 74-50/5010.02

2	WATER WELL OWNER: Botkin Grain Co., Inc.	
	RR#, St. Address, Box # : P.O. Box 145, 813 North Argonia	Board of Agriculture, Division of Water Resources
	City, State, ZIP Code : Argonia, KS 67004-0145	Application Number:

3	LOCATE WELL'S LOCATION WITH AN "X" IN SECTION BOX:	4	DEPTH OF COMPLETED WELL.....	17.0	ft.	ELEVATION:	Not Available
			Depth(s) Groundwater Encountered	1. 9.0	ft.	2.	ft. 3. ft.

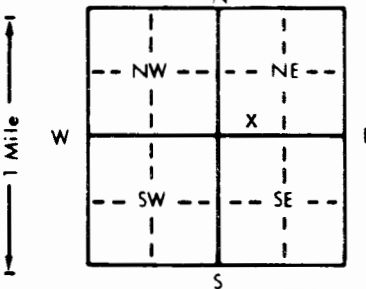

4 DEPTH OF COMPLETED WELL 17.0 ft. ELEVATION: Not Available
 Depth(s) Groundwater Encountered 1. 9.0 ft. 2. ft. 3. ft.
 WELL'S STATIC WATER LEVEL 8.82 ft. below land surface measured on mo/day/yr 9/6/90
 Pump test data: Well water was ft. after hours pumping gpm
 Est. Yield gpm: Well water was ft. after hours pumping gpm
 Bore Hole Diameter 6.5 in. to ft., and in. to ft.
 WELL WATER TO BE USED AS: 5 Public water supply 8 Air conditioning 11 Injection well
 1 Domestic 3 Feedlot 6 Oil field water supply 9 Dewatering 12 Other (Specify below)
 2 Irrigation 4 Industrial 7 Lawn and garden only 10 Monitoring well SW-F
 Was a chemical/bacteriological sample submitted to Department? Yes.....No.....X.....; If yes, mo/day/yr sample was submitted
 Water Well Disinfected? Yes No X

5	TYPE OF BLANK CASING USED:		5 Wrought iron	8 Concrete tile	CASING JOINTS: Glued Clamped Welded Threaded. x
	1 Steel	3 RMP (SR)	6 Asbestos-Cement	9 Other (specify below)	
	x PVC	4 ABS	7 Fiberglass		

Blank casing diameter 2.0 in. to 3.5 ft., Dia in. to ft., Dia in. to ft.
Casing height above land surface flush in., weight lbs./ft. Wall thickness or gauge No.

TYPE OF SCREEN OR PERFORATION MATERIAL:			☒ PVC	10 Asbestos-cement
1 Steel	3 Stainless steel	5 Fiberglass	8 RMP (SR)	11 Other (specify)
2 Brass	4 Galvanized steel	6 Concrete tile	9 ABS	12 None used (open hole)

SCREEN OR PERFORATION OPENINGS ARE:

1 Continuous slot	3 Mill slot	5 Gauzed wrapped	8 Saw cut	11 None (open hole)
2 Louvered shutter	4 Key punched	6 Wire wrapped	9 Drilled holes	
		7 Torch cut	10 Other (specify)	

SCREEN PERFORATED INTERVALS: From 3.5' to 17.0' # From # to #

SCREEN-PERFORATED INTERVALS:	From 3.5 . . . ft. to 17.0 . . . ft.,	From ft. to ft.
	From ft. to ft.,	From ft. to ft.
GRAVEL PACK INTERVALS:	From 2.5 . . . ft. to 17.0 . . . ft.,	From ft. to ft.
	From ft. to ft.,	From ft. to ft.

5. GROUT MATERIAL: 1 Neat cement 2 Cement grout 3 Bentonite 4 Other Volclay
Grout Intervals: From 0 ft. to 1.5 ft., From _____ ft. to _____ ft., From _____ ft. to _____ ft.

What is the nearest source of possible contamination:

1 Septic tank	4 Lateral lines	7 Pit privy	10 Livestock pens	14 Abandoned water well
2 Sewer lines	5 Cess pool	8 Sewage lagoon	11 Fuel storage	15 Oil well/Gas well
3 Watertight sewer lines	6 Seepage pit	9 Feedyard	12 Fertilizer storage	16 Other (specify below)
			13 Insecticide storage	Fuel Service Island

Direction from well?		Northeast		How many feet?		80	
----------------------	--	-----------	--	----------------	--	----	--

[illegible]

7 CONTRACTOR'S OR LANDOWNER'S CERTIFICATION: This water well was (1) constructed, (2) reconstructed, or (3) plugged under my jurisdiction and was completed on (mo/day/year) 8/31/90 and this record is true to the best of my knowledge and belief. Kansas Water Well Contractor's License No. 471-A This Water Well Record was completed on (mo/day/yr) 9/25/90 under the business name of HWS Technologies Inc. by (signature) 