


1 LOCATION OF WATER WELL: Fraction Section Number Township Number Range Number  
 COUNTY: MORTON SE 1/4 SE 1/4 NW 1/4 16 T 32 S R 41 W

Distance and direction from nearest town or city street address of well if located within city?  
 RICHPIELD, KS 67953-

2 WATER WELL OWNER: UNITED METHODIST CHURCH  
 RR#, St. Address, Box #: % DAVE BASHFORD Board of Agriculture, Division of Water Resources  
 City, State, ZIP code: RICHPIELD, KS 67953- Application Number:

3 LOCATE WELL'S LOCATION WITH AN "X" IN SECTION BOX:

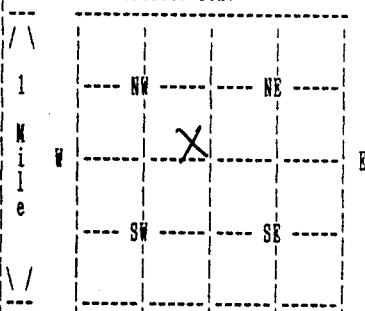

4 DEPTH OF COMPLETED WELL 318 ELEVATION: 0  
 Depth(s) Groundwater Encountered 1. 0 ft. 2. 0 ft. 3. 0 ft.

WELL'S STATIC WATER LEVEL 55 ft. below land surface measured on no/day/yr 08/01/95  
 Pump test data: Well water was 0 ft. after 0 hours pumping 0 gpm

Estimated Yield 25 gpm: Well water was 0 ft. after 0 hours pumping 0 gpm

Bore Hole Diameter 9 in. to 318 ft., and in. to 0 ft.

WELL WATER TO BE USED AS: DOMESTIC

Was a chemical/bacteriological sample submitted to department? No ;  
 If yes, no/day/yr sample was submitted Water well disinfected? Yes

5 TYPE OF BLANK CASING USED: PVC CASING JOINTS: GLUED  
 Blank casing diameter 5 in. to 318 ft., Dia in. to 0 ft., Dia in. to 0 ft.  
 Casing height above land surface 12 in., weight 200 lbs/ft. Wall thickness or gauge No. 21  
 TYPE OF SCREEN OR PERFORATION MATERIAL: PVC  
 SCREEN OR PERFORATION OPENINGS ARE: SAW CUT

SCREEN PERFORATED INTERVALS: From 120 ft. to 160 ft., From 0 ft. to 0 ft.  
 From 298 ft. to 318 ft., From 0 ft. to 0 ft.  
 GRAVEL PACK INTERVALS: From 40 ft. to 318 ft., From 0 ft. to 0 ft.  
 From 0 ft. to 0 ft., From 0 ft. to 0 ft.

6 GROUT MATERIAL BENTONITE  
 Grout Intervals: From 0 ft. to 40 ft., From 0 ft. to 0 ft., From 0 ft. to 0 ft.  
 What is the nearest source of possible contamination: ABANDONED WELL  
 Direction from well? SOUTHEAST How many feet? 25

FROM	TO	LITHOLOGIC LOG	FROM	TO	PLUGGING INTERVALS
0	20	TOPSOIL MEDIUM SAND CLAY			
20	35	SANDY CLAY			
35	40	PINE SAND			
40	105	BROWN CLAY			
105	120	CLAY SAND			
120	140	SAND CLAY			
140	153	MEDIUM SAND			
153	185	SANDY CLAY			
185	195	RED BED			
195	200	CLAY			

7 CONTRACTOR'S OR LANDOWNER'S CERTIFICATION: This water well was Constructed under my jurisdiction and was completed on (no/day/year) 08/01/95 and this record is true to the best of my knowledge and belief. Kansas Water Well Contractor's License No. 179 This Water Well Record was completed on (no/day/yr) 09/05/95 under the business name of JOB'S WELL SERVICE, INC. by (signature) *Judith Critt*

1 LOCATION OF WATER WELL: Fraction Section Number Township Number Range Number  
 COUNTY: MORTON SE 1/4 SE 1/4 NW 1/4 16 T 32 S R 41 W

2 WATER WELL OWNER: UNITED METHODIST CHURCH  
 RR#, St. Address, Box #: % DAVE BASHFORD Board of Agriculture, Division of Water Resources  
 City, State, ZIP code: RICHPIELD, KS 67953- Application Number:

FROM	TO	LITHOLOGIC LOG
200	285	CLAY SAND ROCK
285	315	CLAY SAND ROCK
315	320	ROCK