


WATER WELL RECORD Form WWC-5 KSA 82a-1212

1 LOCATION OF WATER WELL: Fraction Section Number Township Number Range Number  
 COUNTY: 065 MORTON NW 1/4 NW 1/4 NE 1/4 28 T 32 S R 41 W

Distance and direction from nearest town or city street address of well if located within city?  
 FROM RICHFIELD; APPX 1 MILE SOUTH

2 WATER WELL OWNER: FRED CLAASSEN  
 RR#, St. Address, Box # : 960 ROAD X Board of Agriculture, Division of Water Resources  
 City, State, ZIP code : RICHFIELD, KS 67953- Application Number:

3 LOCATE WELL'S LOCATION WITH AN "X" IN SECTION BOX:

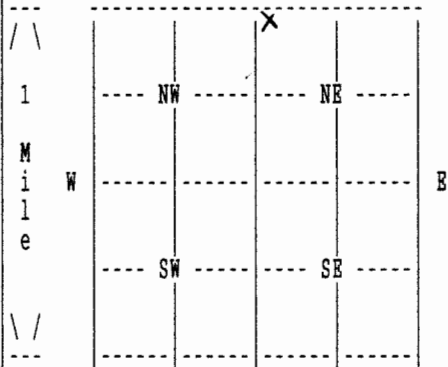

4 DEPTH OF COMPLETED WELL 265 ELEVATION: 0  
 Depth(s) Groundwater Encountered 1. 0 ft. 2. 0 ft. 3. 0 ft.

WELL'S STATIC WATER LEVEL 73 ft. below land surface measured on mo/day/yr 12/06/04  
 Pump test data: Well water was 0 ft. after 0 hours pumping 0 gpm

Estimated Yield 0 gpm: Well water was 0 ft. after 0 hours pumping 0 gpm

Bore Hole Diameter 10 in. to 265 ft., and in. to 0 ft.

WELL WATER TO BE USED AS: 01 DOMESTIC

Was a chemical/bacteriological sample submitted to department? No ;  
 If yes, mo/day/yr sample was submitted Water well disinfected? Yes

5 TYPE OF BLANK CASING USED: 02 PVC CASING JOINTS: GLUED  
 Blank casing diameter 5 in. to 265 ft., Dia in. to 0 ft., Dia in. to 0 ft.  
 Casing height above land surface 12 in., weight 3 lbs/ft. Wall thickness or gauge No. .265  
 TYPE OF SCREEN OR PERFORATION MATERIAL: 07 PVC  
 SCREEN OR PERFORATION OPENINGS ARE: 03 MILL SLOT

SCREEN PERFORATED INTERVALS: From 165 ft. to 185 ft., From 0 ft. to 0 ft.  
 From 225 ft. to 265 ft., From 0 ft. to 0 ft.  
 GRAVEL PACK INTERVALS: From 25 ft. to 265 ft., From 0 ft. to 0 ft.  
 From 0 ft. to 0 ft., From 0 ft. to 0 ft.

6 GROUT MATERIAL 03 BENTONITE  
 Grout Intervals: From 2 ft. to 25 ft., From 0 ft. to 0 ft., From 0 ft. to 0 ft.  
 What is the nearest source of possible contamination: NONE OBSERVED  
 Direction from well? How many feet? 0

FROM	TO	LITHOLOGIC LOG	FROM	TO	PLUGGING INTERVALS
0	2	02 SILT			
2	36	04 SANDY CLAY			
36	49	01 CLAY			
49	59	07 FINE SAND			
59	124	01 CLAY			
124	179	07 FINE SAND			
179	181	05 SAND			
181	183	04 SANDY CLAY			
183	200	07 FINE SAND 01 CLAY			
200	222	01 CLAY			

7 CONTRACTOR'S OR LANDOWNER'S CERTIFICATION: This water well was Constructed under my jurisdiction and was completed on (mo/day/year) 12/09/04 and this record is true to the best of my knowledge and belief. Kansas Water Well Contractor's License No. 145 This Water Well Record was completed on (mo/day/yr) 04/14/05 under the business name of HENKLE DRILLING & SUPPLY by (signature)

(Continued)

WATER WELL RECORD Form WWC-5 KSA 82a-1212

1 LOCATION OF WATER WELL:      Fraction      Section Number      Township Number      Range Number  
COUNTY: 065 MORTON      1/4      28      T 32      S      R 41      W

2 WATER WELL OWNER:      FRED CLAASSEN  
RR#, St. Address, Box # : 960 ROAD X      Board of Agriculture, Division of Water Resources  
City, State, ZIP code : RICHFIELD, KS      67953-      Application Number: |

FROM	TO	LITHOLOGIC LOG
222	235	23 SANDSTONE 31 CALICHE
235	238	31 CALICHE
238	250	23 SANDSTONE 31 CALICHE
250	265	23 SANDSTONE 31 CALICHE
265	282	31 CALICHE

7 CONTRACTOR'S OR LANDOWNER'S CERTIFICATION: This water well was Constructed under my jurisdiction and was completed on (mo/day/year) 12/09/04 and this record is true to the best of my knowledge and belief. Kansas Water Well Contractor's License No. 145      This Water Well Record was completed on (mo/day/yr) 04/14/05  
under the business name of HENKLE DRILLING & SUPPLY      by (signature) *Brian J. Richman*