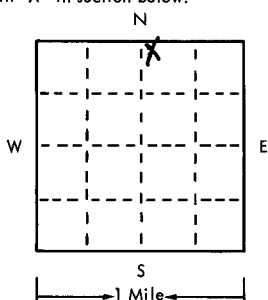


USE TYPEWRITER OR BALL  
POINT PEN-PRESS FIRMLY,  
PRINT CLEARLY.

WATER WELL RECORD  
KSA 82a-1201-1215

3241W 3NWWE  
T R EW sec 1/4 1/4 1/4 No.

Kansas State Dept. Of Health  
(Water Well Contractors)  
Forbes-Bldg. 740  
Topeka, Kansas 66620

1 Location of well:	County <u>MORTON</u>	Township name <u>NW 1/4 NW 1/4 Sec 3</u>	Fraction <u>3</u>	Section number <u>T 32S</u>	Town number <u>R 41W</u>	Range number
Distance and direction from nearest town or city: <u>3 South East of Richfield, Kansas</u>			3 Owner of well: <u>Ladd Petroleum, Inc.</u> Address: <u>Box 294 Liberal, Kansas</u>			
Locate with "X" in section below: 			Sketch map:			4 Well depth: <u>404</u> ft. Date of completion <u>9/11/75</u> Well diameter <u>12 1/2</u> in.
2 Type and color of material			From		To	5 <input type="checkbox"/> Cable tool <input checked="" type="checkbox"/> Rotary <input type="checkbox"/> Driven <input type="checkbox"/> Dug <input type="checkbox"/> Hollow rod <input type="checkbox"/> Jetted <input type="checkbox"/> Bored <input type="checkbox"/> Reverse rotary
						6 Use: <input type="checkbox"/> Domestic <input type="checkbox"/> Public supply <input checked="" type="checkbox"/> Industry <input type="checkbox"/> Irrigation <input type="checkbox"/> Air conditioning <input type="checkbox"/> Commercial <input type="checkbox"/> Test well <input type="checkbox"/>
Top Soil			0		2	7 Casing: Material <u>Steel</u> Height: above/below Threaded <input type="checkbox"/> Welded <input checked="" type="checkbox"/> Surface <u>12</u> in. Diam. <u>8 3/8</u> in. to <u>404</u> ft. depth Weight <u>9.6</u> lbs./ft. <u>1</u> Drive shoe? <input type="checkbox"/> Yes <input checked="" type="checkbox"/> No
Overburden			2		120	8 Screen: Manufacturer <u>L. B. Foster</u> Type <u>Steel</u> Dia. <u>8 3/8</u> Slot/gauze <u>1/8</u> Length <u>3</u> Set between <u>104</u> ft. and <u>404</u> ft. Fittings: <u>1/4 to 1/4</u> Gravel pack <input checked="" type="checkbox"/> Yes <input type="checkbox"/> No Size range of material
Fine Sd. & Clay			120		160	9 Static water level: ____ ft. below land surface Date
Clay			160		180	10 Pumping level below land surfaces: <u>NA</u> ____ ft. after ____ hrs. pumping ____ g.p.m. ____ ft. after ____ hrs. pumping ____ g.p.m. Estimated maximum yield ____ g.p.m.
Fine & Med. Sd. w/Yellow Shale			180		240	11 Water sample submitted: <input type="checkbox"/> Yes <input checked="" type="checkbox"/> No Date
Sd. & Sd. w/Red & Yellow Shale			240		320	12 Well head completion: <input type="checkbox"/> Pitless adapter <u>NA</u> <input type="checkbox"/> Inches above grade
Sd. Stone & Shale			320		402	13 Well grouted? <input checked="" type="checkbox"/> Yes <input type="checkbox"/> No <input checked="" type="checkbox"/> Neat cement <input type="checkbox"/> Bentonite <input type="checkbox"/> Depth: From <u>0</u> ft. to <u>20</u> ft.
Red Bed			402		405	14 Nearest source of possible contamination: ft. ____ Direction ____ Type ____ Well disinfected upon completion? <input type="checkbox"/> Yes <input checked="" type="checkbox"/> No
(use a second sheet if needed)						15 Pump: <input type="checkbox"/> Not installed Manufacturer's name ____ Model number ____ HP ____ Volts ____ Length of drop pipe ____ ft. capacity ____ g.m.p. Type: <u>Pump Set By Third Party</u> <input type="checkbox"/> Submersible <input type="checkbox"/> Turbine <input type="checkbox"/> Jet <input type="checkbox"/> Reciprocating <input type="checkbox"/> Centrifugal <input type="checkbox"/> Other
16 Remarks: elevation <u>8A None</u> <u>14 Crop Land</u>			17 Water well contractor's certification: This well was drilled under my jurisdiction and this report is true to the best of my knowledge and belief. <u>KTM DRILLING, INC.</u> 225 Business name <u>Box 1385 Guymon, OK 1A</u> License No. ____ Address <u>Asbury, Oklahoma</u> Date <u>9/11/75</u> Signed <u>Asbury</u> Authorized representative			

32 41W 3 NW NW NE