


USE TYPEWRITER OR BALL POINT PEN—PRESS FIRMLY, PRINT CLEARLY.

WATER WELL RECORD
KSA 82a-1201-1215

Kansas Department of Health and Environment—Division of Environment
(Water well Contractors)
Topeka, Kansas 66620

1. Location of well:	County <i>Morton</i>	Fraction <i>NE 1/4 SE 1/4 NE 1/4</i>	Section number <i>16</i>	Township number T <i>32</i> S	Range number R <i>41 W</i> E/W
----------------------	-------------------------	---	-----------------------------	----------------------------------	-----------------------------------

2. Distance and direction from nearest town or city: Street address of well (location if in city): <i>Taylor Blvd. Richfield, Kansas Lat 19</i>	3. Owner of well: R.R. or street: City, state, zip code: <i>Bill Maxord Richfield, Mo 67853</i>
---	--

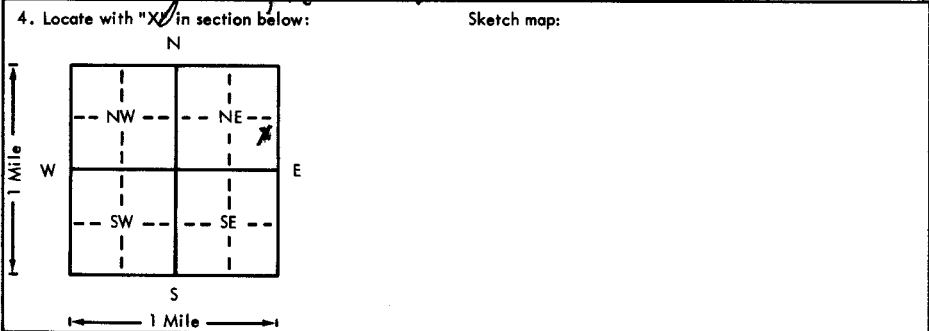

5. Type and color of material	From	To
<i>fine sand</i>	<i>0'</i>	<i>20'</i>
<i>Clay</i>	<i>20'</i>	<i>110'</i>
<i>sand-med.</i>	<i>110'</i>	<i>125'</i>
<i>monsoon clay</i>	<i>125'</i>	<i>140'</i>
<i>rock</i>	<i>140'</i>	<i>150'</i>
<i>sandstone</i>	<i>150'</i>	<i>320'</i>
<i>red bed</i>	<i>320'</i>	

6. Bore hole dia. <i>9</i> in. Completion date <i>7 79</i> Well depth <i>320</i> ft.
7. Cable tool <input checked="" type="checkbox"/> Rotary <input type="checkbox"/> Driven <input type="checkbox"/> Dug <input type="checkbox"/> Hollow rod <input type="checkbox"/> Jetted <input type="checkbox"/> Bored <input type="checkbox"/> Reverse rotary
8. Use: <input checked="" type="checkbox"/> Domestic <input type="checkbox"/> Public supply <input type="checkbox"/> Industry <input type="checkbox"/> Irrigation <input type="checkbox"/> Air conditioning <input type="checkbox"/> Stock <input type="checkbox"/> Lawn <input type="checkbox"/> Oil field water <input type="checkbox"/> Other
9. Casing: Material _____ Height: Above or below Threaded _____ Surface <i>18</i> in. RMP _____ PVC <input checked="" type="checkbox"/> Weight _____ lbs./ft. Dia. <i>5</i> in. to <i>10</i> ft. depth Wall Thickness: inches or Dia. _____ in. to _____ ft. depth gage No. <i>262</i>
10. Screen: Manufacturer's name _____ <i>Jetstream</i> Type <i>PVC</i> Dia. <i>5"</i> Slot/ size <i>slot</i> Length <i>40</i> Set between <i>280</i> ft. and <i>320</i> ft. _____ ft. and _____ ft. Gravel pack? <input checked="" type="checkbox"/> Yes Size range of material <i>#1</i>
11. Static water level: _____ mp./day/yr. <i>40'</i> ft. below land surface Date <i>7/79</i>
12. Pumping level below land surfaces: <i>60</i> ft. after <i>12</i> hrs. pumping <i>30</i> g.p.m. _____ ft. after _____ hrs. pumping _____ g.p.m. Estimated maximum yield <i>40 gpm</i> g.p.m.
13. Water sample submitted: _____ mo./day/yr. Yes <input checked="" type="checkbox"/> No <input type="checkbox"/> Date _____
14. Well head completion: <input checked="" type="checkbox"/> Pitless adapter <i>18"</i> inches above grade
15. Well grouted? <input checked="" type="checkbox"/> Yes With: _____ Neat cement _____ Bentonite <input checked="" type="checkbox"/> Concrete Depth: From <i>5</i> ft. to <i>30</i> ft.
<input checked="" type="checkbox"/> Nearest source of possible contamination: <i>N.A.</i> ft. _____ Direction _____ Type _____ Well disinfected upon completion? <input checked="" type="checkbox"/> Yes <input type="checkbox"/> No
17. Pump: _____ Not installed Manufacturer's name <i>FWW</i> Model number <i>19-15</i> HP <i>1 1/2</i> Volts <i>230</i> Length of drop pipe <i>162</i> ft. capacity <i>20</i> g.p.m. Type: <input checked="" type="checkbox"/> Submersible <input type="checkbox"/> Turbine <input type="checkbox"/> Jet <input type="checkbox"/> Reciprocating <input type="checkbox"/> Centrifugal <input type="checkbox"/> Other

18. Elevation:
Topography: _____ Hill
 Slope
_____ Upland
_____ Valley

19. Remarks:
(Use a second sheet if needed)

20. Water well contractor's certification:
This well was drilled under my jurisdiction and this report is true to the best of my knowledge and belief.
James Smith Pump Co 160
Business name License No.
Address *Johnson, Kansas 67853*
Signed *James Ray Smith* Date *1/8/80*
Authorized representative

T 32 R 41 W 16 NE SE NE