

USE TYPEWRITER OR BALL
POINT PEN-PRESS FIRMLY,
PRINT CLEARLY.

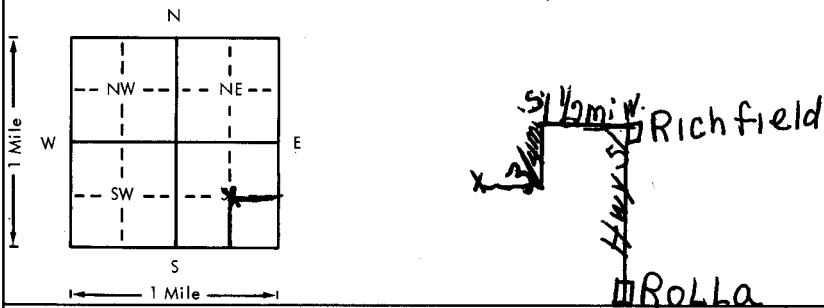
WATER WELL RECORD
KSA 82a-1201-1215

Kansas Department of Health and
Environment-Division of Environment
(Water well Contractors)
Topeka, Kansas 66620

Permit No T 79-164

CWW 16269

Anaya #1

1. Location of well:		County Morton	Fraction X4 XC-SE/4	Section number 19	Township number T 32 S	Range number R 41 E/W
2. Distance and direction from nearest town or city: From Rolla go N. to Richfield then 1 1/2 mi west 3/4 mi south back west to location			3. Owner of well: Sovereign Exploration R.R. or street: 4821 First International Bldg. City, state, zip code: Dallas, Texas 75270			
4. Locate with "X" in section below: 			6. Bore hole dia. 9 in. Completion date 9-18-79 Well depth 240 ft.			
5. Type and color of material			7. <input type="checkbox"/> Cable tool <input checked="" type="checkbox"/> Rotary <input type="checkbox"/> Driven <input type="checkbox"/> Dug <input type="checkbox"/> Hollow rod <input type="checkbox"/> Jetted <input type="checkbox"/> Bored <input type="checkbox"/> Reverse rotary			
Surface			8. Use: <input type="checkbox"/> Domestic <input type="checkbox"/> Public supply <input type="checkbox"/> Industry <input type="checkbox"/> Irrigation <input type="checkbox"/> Air conditioning <input type="checkbox"/> Stock <input type="checkbox"/> Lawn <input checked="" type="checkbox"/> Oil field water <input type="checkbox"/> Other			
Rock			9. Casing: Material <input type="checkbox"/> Height: Above or below Threaded <input type="checkbox"/> Welded <input type="checkbox"/> Surface 28 in. RMP <input type="checkbox"/> PVC <input checked="" type="checkbox"/> Weight 2.56 lbs./ft. Dia. 5 in. to 160 ft. depth Wall Thickness: inches or Dia. <input type="checkbox"/> in. to <input type="checkbox"/> ft. depth gage No. .278			
20% fine sand & 80% caliche			10. Screen: Manufacturer's name <input type="checkbox"/> Type Sawed Dia. 5" Slot/gauze .030 Length 80 Set between 160 ft. and 240 ft. Gravel pack? Yes Size range of material 1/8-3/16			
85% clay & fine sand			11. Static water level: <input type="checkbox"/> mo./day/yr. 98 ft. below land surface Date 9-18-79			
Fine sand			12. Pumping level below land surfaces: <input type="checkbox"/> ft. after <input type="checkbox"/> hrs. pumping <input type="checkbox"/> g.p.m. <input type="checkbox"/> ft. after <input type="checkbox"/> hrs. pumping <input type="checkbox"/> g.p.m. Estimated maximum yield 60 g.p.m.			
25% fine sand & 75% sand stone			13. Water sample submitted: <input type="checkbox"/> mo./day/yr. <input type="checkbox"/> Yes <input checked="" type="checkbox"/> No Date <input type="checkbox"/>			
			14. Well head completion: <input checked="" type="checkbox"/> Pitless adapter 28 inches above grade			
			15. Well grouted? Yes With: <input checked="" type="checkbox"/> Neat cement <input type="checkbox"/> Bentonite <input type="checkbox"/> Concrete Depth: From 0 ft. to 10 ft.			
			16. Nearest source of possible contamination: ft. 100 Direction N.E Type Oil well Well disinfected upon completion? <input checked="" type="checkbox"/> Yes <input type="checkbox"/> No			
			17. Pump: <input checked="" type="checkbox"/> Not installed Manufacturer's name <input type="checkbox"/> Model number <input type="checkbox"/> HP <input type="checkbox"/> Volts <input type="checkbox"/> Length of drop pipe <input type="checkbox"/> ft. capacity <input type="checkbox"/> g.p.m. Type: <input type="checkbox"/> Submersible <input type="checkbox"/> Turbine <input type="checkbox"/> Jet <input type="checkbox"/> Reciprocating <input type="checkbox"/> Centrifugal <input type="checkbox"/> Other			
18. Elevation:			20. Water well contractor's certification: This well was drilled under my jurisdiction and this report is true to the best of my knowledge and belief. #118 Carlile Water Well Service Business name <input type="checkbox"/> License No. <input type="checkbox"/> Address Box AA Liberal, Kansas Signed Edward E. Means Date 9-24-79 Authorized representative			
19. Remarks:						
Topography: <input type="checkbox"/> Hill <input checked="" type="checkbox"/> Slope <input type="checkbox"/> Upland <input type="checkbox"/> Valley						