

1 LOCATION OF WATER WELL:	Fraction	Section Number	Township Number	Range Number
County: MORTON	SE 1/4 NW 1/4 SE 1/4	35	T 32 S	R 42 W

Distance and direction from nearest town or city street address of well if located within city?

RICHFIELD-WHILBURTON HWY. - 5-6 MILES SOUTH, WEST Q16, NORTH 3 MILES Q13, 1 MILE WEST R13, 1 1/2 MILES N

2 WATER WELL OWNER: BOB J. ANDERSON


RR#, St. Address, Box #: HCo 2 BOX 71

Board of Agriculture, Division of Water Resources

City, State, ZIP Code: ROLLA, KS 67954

Application Number: 10183

3 LOCATE WELL'S LOCATION WITH AN "X" IN SECTION BOX:

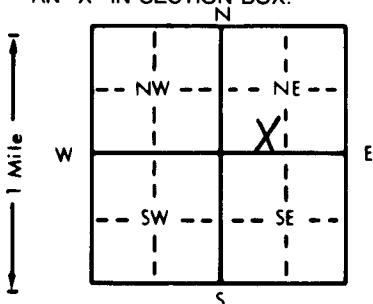

4 DEPTH OF COMPLETED WELL: 480 ft. ELEVATION: 3600 ft.

Depth(s) Groundwater Encountered 1. 85 ft. 2. ft. 3. ft.

WELL'S STATIC WATER LEVEL 85 ft. below land surface measured on mo/day/yr 05/15/96

Pump test data: Well water was N/A ft. after hours pumping gpm

Est. Yield N/A gpm: Well water was ft. after hours pumping gpm

Bore Hole Diameter 24 in. to 480 ft. and in. to ft.

WELL WATER TO BE USED AS: 5 Public water supply 8 Air conditioning 11 Injection well

1 Domestic 3 Feedlot 6 Oil field water supply 9 Dewatering 12 Other (Specify below)

2 Irrigation 4 Industrial 7 Lawn and garden only 10 Monitoring well

Was a chemical/bacteriological sample submitted to Department? Yes No X; If yes, mo/day/yr sample was submitted

Water Well Disinfected? Yes X No

5 TYPE OF BLANK CASING USED:

- 1 Steel
2 PVC
3 RMP (SR)
4 ABS

5 Wrought iron

6 Asbestos-Cement

7 Fiberglass

8 Concrete tile

9 Other (specify below)

CASING JOINTS: Glued X Clamped

Welded X

Threaded

Blank casing diameter 16 in. to 148 ft. Dia. in. to ft. Dia. in. to ft.

Casing height above land surface 12 in. weight 42.05 lbs./ft. Wall thickness or gauge No. 250

TYPE OF SCREEN OR PERFORATION MATERIAL:

- 1 Steel
2 Brass
3 Stainless steel
4 Galvanized steel

5 Fiberglass

6 Concrete tile

7 PVC

8 RMP (SR)

9 ABS

10 Asbestos-cement

11 Other (specify)

12 None used (open hole)

SCREEN OR PERFORATION OPENINGS ARE:

- 1 Continuous slot
2 Louvered shutter
3 Mill slot
4 Key punched

5 Gauzed wrapped

6 Wire wrapped

7 Torch cut

8 Saw cut

9 Drilled holes

10 Other (specify)

11 None (open hole)

SCREEN-PERFORATED INTERVALS: From 148 ft. to 468 ft. From ft. to ft.

From ft. to ft. From ft. to ft.

GRAVEL PACK INTERVALS: From 20 ft. to 468 ft. From ft. to ft.

From ft. to ft. From ft. to ft.

6 GROUT MATERIAL:

1 Neat cement

2 Cement grout

3 Bentonite

4 Other

Grout Intervals: From ft. to ft. From 1 ft. to 20 ft. From ft. to ft.

What is the nearest source of possible contamination:

- 1 Septic tank
2 Sewer lines
3 Watertight sewer lines
4 Lateral lines
5 Cess pool
6 Seepage pit

- 7 Pit privy
8 Sewage lagoon
9 Feedyard

10 Livestock pens

11 Fuel storage

12 Fertilizer storage

13 Insecticide storage

14 Abandoned water well

15 Oil well/Gas well

16 Other (specify below)

Direction from well?

How many feet? 300 ft

FROM	TO	LITHOLOGIC LOG	FROM	TO	LOG
0	85	SURFACE -CALICHE	370	380	FINE RED SAND W/ 30% CLAY
85	170	FINE SAND	380	390	FINE-MEDIUM SAND W/ RED CALY STREAK
170	200	FINE-MEDIUM SAND W/ CLAY STRINGERS	390	400	FINE-MEDIUM SAND W/ RED CLAY STREAK
200	220	MEDIUM SAND W/ CLAY STRINGERS	400	420	FINE RED SAND W/ 20% CLAY
220	240	MEDIUM-COARSE SAND	420	440	FINE RED SAND W/ 20% CLAY
240	260	MEDIUM-COARSE SAND W/ 10% CLAY	440	450	FINE RED SAND W/ 50% CLAY
260	280	MEDIUM-COARSE SAND W/ SANDSTONE & CLAY	450	460	RED CLAY W/ FINE SAND STREAKS
280	290	FINE-MED RED SAND W/ CLAY STRINGERS	460	470	RED CLAY W/ FINE SAND
290	300	MED.-COARSE RED SAND W/ CLAY STRING	470	480	RED CLAY W/ FINE SAND
300	310	FINE RED SAND W/ 10% CLAY			
310	320	FINE RED SAND W/ 20% CLAY			
320	330	FINE-MED RED SAND W/ 20% CLAY			
330	350	FINE RED SAND W/ 20% CLAY			
350	360	FINE-MED RED SAND W/ 40% CLAY			
360	370	FINE RED SAND W/ 50% CLAY			

7 CONTRACTOR'S OR LANDOWNER'S CERTIFICATION: This water well was (1) constructed (2) reconstructed, or (3) plugged under my jurisdiction and was completed on (mo/day/year) 05/15/96 and this record is true to the best of my knowledge and belief. Kansas

Water Well Contractor's License No. 164 This Water Well Record was completed on (mo/day/yr) 05/26/96

under the business name of WATER RIGHT IRRIGATION, INC.

by (signature) Kelly J. Jones