

USE TYPEWRITER OR BALL
POINT PEN-PRESS FIRMLY,
PRINT CLEARLY.

WATER WELL RECORD
KSA 82a-1201-1215

T R EW sec 1/4 1/4 1/4 No.

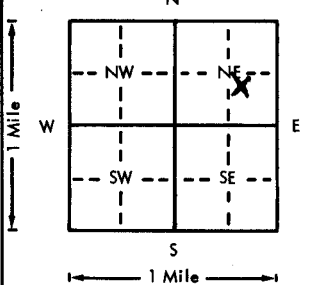
Kansas State Dept. Of Health
(Water Well Contractors)
Forbes-Bldg. 740
Topeka, Kansas 66620

1 Location of well:		County MONTON	Township name WestOLA	Fraction SE 1/4 NE 1/4	Section number 17	Town number 32	Range number 42
Distance and direction from nearest town or city: 19 M NORTH 1/2 W Elkhan, KANS				3 Owner of well: EMERY STOOPS Address: 10736 LE-CONTE AVE. LOS ANGELES CALIF. 90034			
Locate with "X" in section below:		Sketch map:		4 Well depth: 424 ft. Date of completion NOV 10-75 Well diameter 19 in.			
				5 <input type="checkbox"/> Cable tool <input checked="" type="checkbox"/> Rotary <input type="checkbox"/> Driven <input type="checkbox"/> Dug <input type="checkbox"/> Hollow rod <input type="checkbox"/> Jetted <input type="checkbox"/> Bored <input type="checkbox"/> Reverse rotary			
2		Type and color of material		From	To	6 Use: <input type="checkbox"/> Domestic <input type="checkbox"/> Public supply <input type="checkbox"/> Industry <input checked="" type="checkbox"/> Irrigation <input type="checkbox"/> Air conditioning <input type="checkbox"/> Commercial <input type="checkbox"/> Test well <input type="checkbox"/>	
		Top-Clay-Gyp Rock		0	50	7 Casing: Material 219 Height: above below Threaded <input type="checkbox"/> Welded <input checked="" type="checkbox"/> Surface 18 in. Diam. 16 in. to 220 depth Drive shoe? <input type="checkbox"/> Yes <input checked="" type="checkbox"/> No 14 in. to 424 depth	
		SAND & CLAY		50	95	8 Screen: Manufacturer _____ Type _____ Dia. _____ Slot/gauze 1/2" cut Length 80 Set between 120 ft. and 220 ft. 424 Fittings: Gravel pack <input checked="" type="checkbox"/> Yes <input type="checkbox"/> No Size range of material 3/4 Rock	
		Red & TAN S.R. Silty		95	145	9 Static water level: 120 ft. below land surface Date NOV 10-75	
		TAN CHUNKY S.R. CLAY STK'S		145	173	10 Pumping level below land surfaces: 400 ft. after 12 hrs. pumping 450 g.p.m. _____ ft. after _____ hrs. pumping _____ g.p.m. Estimated maximum yield 450 g.p.m.	
		Green CLAY STK'S TAN S.R. STK'S		173	245	11 Water sample submitted: <input type="checkbox"/> Yes <input checked="" type="checkbox"/> No Date _____	
		Yel. & TAN S.R. CLAY STK'S		245	265	12 Well head completion: <input type="checkbox"/> Pitless adapter <input type="checkbox"/> Inches above grade	
		White & TAN S.R. Red S.R. STK'S		265	310	13 Well grouted? <input type="checkbox"/> Yes <input checked="" type="checkbox"/> No <input type="checkbox"/> Neat cement <input type="checkbox"/> Bentonite <input checked="" type="checkbox"/> Cement Depth: From 12 ABOVE to 10 ft Below Ground	
		Red S.R. TAN S.R. STK'S Clean		310	375	14 Nearest source of possible contamination: NONE ft. _____ Direction _____ Type _____ Well disinfected upon completion? <input type="checkbox"/> Yes <input type="checkbox"/> No	
		Red S.R. Broken using water		375	420	15 Pump: <input checked="" type="checkbox"/> Not installed Manufacturer's name _____ Model number _____ HP _____ Volts _____ Length of drop pipe _____ ft. capacity _____ g.p.m. Type: <input type="checkbox"/> Submersible <input type="checkbox"/> Turbine <input type="checkbox"/> Jet <input type="checkbox"/> Reciprocating <input type="checkbox"/> Centrifugal <input type="checkbox"/> Other	
		Red CLAY & SHALE		420	424	17 Water well contractor's certification: This well was drilled under my jurisdiction and this report is true to the best of my knowledge and belief. Rollins Irrigation Drilling Contr. Business name _____ License No. 154A Address 700 S. MAIN Signed Rollins Date _____ Authorized representative Springfield, Colo. 81073	
16 Remarks: elevation Topography: <input type="checkbox"/> Hill <input type="checkbox"/> Slope <input checked="" type="checkbox"/> Upland <input type="checkbox"/> Valley							

USE TYPEWRITER OR BALL
POINT PEN-PRESS FIRMLY,
PRINT CLEARLY.

WATER WELL RECORD
KSA 82a-1201-1215

Kansas Department of Health and
Environment-Division of Environment
(Water well Contractors)
Topeka, Kansas 66620

1. Location of well:		County MONTON	Fraction R.W. NW 1/4 SE 1/4 NE 1/4	Section number 17	Township number West 1/4 33	Range number 42 E
2. Distance and direction from nearest town or city: 19N 1/4 W		3. Owner of well: EMERY STOOPS		R.R. or street: 10736 E-Conte Ave.		
Street address of well location if in city: EIKHART-KANS		City, state, zip code: LOS ANGELES CALIF 90024				
4. Locate with "X" in section below:		Sketch map:		6. Bore hole dia. 19 in. Completion date 8-26-76		
		IRRIGATION Well		Well depth 424 ft.		
5. Type and color of material		From	To	7. Cable tool <input checked="" type="checkbox"/> Rotary <input type="checkbox"/> Driven <input type="checkbox"/> Dug <input type="checkbox"/> Hollow rod <input type="checkbox"/> Jetted <input type="checkbox"/> Bored <input type="checkbox"/> Reverse rotary		
Top Soil		0	50	8. Use: <input type="checkbox"/> Domestic <input type="checkbox"/> Public supply <input type="checkbox"/> Industry <input checked="" type="checkbox"/> Irrigation <input type="checkbox"/> Air conditioning <input type="checkbox"/> Stock <input type="checkbox"/> Lawn <input type="checkbox"/> Oil field water <input type="checkbox"/> Other		
SAND BROWN Silty		50	95	9. Casing: Material Steel Height: Above or below		
SAND Rock Red & TAN Silty		95	145	Threaded <input type="checkbox"/> Welded <input checked="" type="checkbox"/> Surface 15 in.		
SAND Rock Red & TAN Silty		145	173	RMP <input type="checkbox"/> PVC <input type="checkbox"/> Weight 36.86 lbs./ft.		
SAND Rock TAN Clay Green STK'S		173	245	Dia. 16 in. to 220 ft. depth Wall Thickness: inches or		
SAND Rock Yellow & TAN Clay STK'S		245	265	Dia. 14 in. to 424 ft. depth gage No. 1219		
SAND Rock White & TAN & Red		265	310	10. Screen: Manufacturer's name NO SCREEN		
SAND Rock Red & TAN Clean		310	375	LAKELWOOD PIPE OF TEXAS		
SAND Rock Red Porous-using water		375	420	Type Steel Dia. 16		
CLAY & SHALE Red		420	424	Slot/gauge 1/4" Tenth Length 40'		
				Set between 140 ft. and 220 ft.		
				424 ft. and 424 ft.		
				Gravel pack? <input checked="" type="checkbox"/> Size range of material 3/4		
				11. Static water level: 120 ft. below land surface Date 8-26-76		
				12. Pumping level below land surfaces: 400 ft. after 12 hrs. pumping 450 g.p.m.		
				____ ft. after ____ hrs. pumping ____ g.p.m.		
				Estimated maximum yield 450 g.p.m.		
				13. Water sample submitted: ____ mo./day/yr.		
				Yes <input checked="" type="checkbox"/> No <input type="checkbox"/> Date ____		
				14. Well head completion: ____ Pitless adapter ____ inches above grade		
				15. Well grouted? yes		
				With: <input checked="" type="checkbox"/> Neat cement <input type="checkbox"/> Bentonite <input type="checkbox"/> Concrete		
				Depth: From 0 ft. to 10 ft.		
				16. Nearest source of possible contamination: NONE		
				ft. ____ Direction ____ Type ____		
				Well disinfected upon completion? ____ Yes ____ No		
				17. Pump: yes Not installed		
				Manufacturer's name WORTHING Pump Co		
				Model number 1618 HP 200 Volts ____		
				Length of drop pipe 400 ft. capacity 450 g.p.m.		
				Type: ____ Submersible <input checked="" type="checkbox"/> Turbine		
				____ Jet ____ Reciprocating		
				____ Centrifugal ____ Other		
18. Elevation:		19. Remarks:		20. Water well contractor's certification:		
Topography: ____ Hill <input checked="" type="checkbox"/> Slope ____ Upland ____ Valley		Concrete slab to be installed By Customer		This well was drilled under my jurisdiction and this report is true to the best of my knowledge and belief.		
				Business name Ralph's Irrigation Drilling Contr License No. 154		
				Address Springfield, Mo. 65803		
				Signed Ralph E. Woods Date 8-26-76		
				Authorized representative		

32 42 12
R
1/4 1/4 1/4
N USE NE