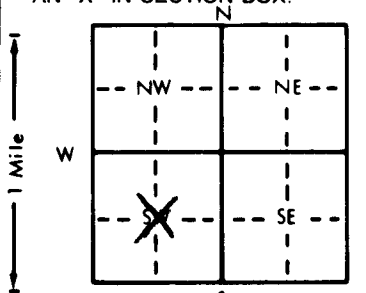


1 LOCATION OF WATER WELL:	Fraction	Section Number	Township Number	Range Number
County: Morton	C $\frac{1}{4}$ SW $\frac{1}{4}$ $\frac{1}{4}$	22	T 32 S	R 43 E (W)

Distance and direction from nearest town or city street address of well if located within city?

From 51 & 27 @ Richfield 6.5W., 1N., 5W., 1.7S., & E. into

2 WATER WELL OWNER: Coastal Oil & Gas	#2-22 Hanke
RR#, St. Address, Box # : 9 Greenway Plz. Ste. 2751	Board of Agriculture, Division of Water Resources
City, State, ZIP Code : Houston, Tx 77046	Application Number: 960406

3 LOCATE WELL'S LOCATION WITH AN "X" IN SECTION BOX:	4 DEPTH OF COMPLETED WELL: 265 ft. ELEVATION:
	Depth(s) Groundwater Encountered 1. 110 ft. 2. ft. 3. ft.
	WELL'S STATIC WATER LEVEL 110 ft. below land surface measured on mo/day/yr 10-30-96
	Pump test data: Well water was 205 ft. after 1 hours pumping 90 gpm
	Est. Yield 90 gpm: Well water was ft. after hours pumping gpm
	Bore Hole Diameter 9 1/2 in. to 265 ft., and in. to ft.
	WELL WATER TO BE USED AS:
	1 Domestic 3 Feedlot 6 Oil field water supply 9 Dewatering 12 Other (Specify below)
	2 Irrigation 4 Industrial 7 Lawn and garden only 10 Monitoring well
	Was a chemical/bacteriological sample submitted to Department? Yes No X ; If yes, mo/day/yr sample was submitted
	Water Well Disinfected? Yes X No

5 TYPE OF CASING USED:	5 Wrought iron	8 Concrete tile	CASING JOINTS: Glued X Clamped
1 Steel	3 RMP (SR)	6 Asbestos-Cement	9 Other (specify below)
2 PVC	4 ABS	7 Fiberglass	10 Asbestos-cement
Blank casing diameter 5 in. to 260 ft., Dia			11 Injection well
Casing height above land surface 24 in., weight 2.902 lbs./ft. Wall thickness or gauge No. 281 SDR 21			12 Other (Specify below)
TYPE OF SCREEN OR PERFORATION MATERIAL:			
1 Steel	3 Stainless steel	5 Fiberglass	8 RMP (SR)
2 Brass	4 Galvanized steel	6 Concrete tile	9 ABS
SCREEN OR PERFORATION OPENINGS ARE:			
1 Continuous slot	3 Mill slot	5 Gauzed wrapped	8 Saw cut
2 Louvered shutter	4 Key punched	6 Wire wrapped	9 Drilled holes
		7 Torch cut	10 Other (specify)
11 None (open hole)			
SCREEN-PERFORATED INTERVALS: From 160 ft. to 260 ft., From ft. to ft.			
GRAVEL PACK INTERVALS: From 60 ft. to 260 ft., From ft. to ft.			

6 GROUT MATERIAL:	1 Neat cement	2 Cement grout	3 Bentonite	4 Other Hole Plug
Grout Intervals: From 0 ft. to 16 ft., From ft. to ft.				
What is the nearest source of possible contamination:				
1 Septic tank	4 Lateral lines	7 Pit privy	10 Livestock pens	14 Abandoned water well
2 Sewer lines	5 Cess pool	8 Sewage lagoon	11 Fuel storage	15 Oil well/Gas well
3 Watertight sewer lines	6 Seepage pit	9 Feedyard	12 Fertilizer storage	16 Other (specify below)
13 Insecticide storage				
Direction from well? Southeast			How many feet? 200	

FROM	TO	LITHOLOGIC LOG	FROM	TO	PLUGGING INTERVALS
0	1	Surface			
1	17	Clay			
17	69	Sandy Clay			
69	86	Sand			
86	100	Clay			
100	107	Sand			
107	115	Clay			
115	131	Red Sandstone			
131	168	Sandstone			
168	186	Fine Sand			
186	220	Sandstone			
220	261	Fine Sand			
261	265	Sand & Clay Streaks			

7 CONTRACTOR'S OR LANDOWNER'S CERTIFICATION: This water well was (1) constructed, (2) reconstructed, or (3) plugged under my jurisdiction and was completed on (mo/day/year) 10-30-96 and this record is true to the best of my knowledge and belief. Kansas Water Well Contractor's License No. KWCL - 430 This Water Well Record was completed on (mo/day/yr) 10-30-96 under the business name of Howard Drlg. Box 806, Beaver, Ok 73932 by (signature) <i>[Signature]</i>
