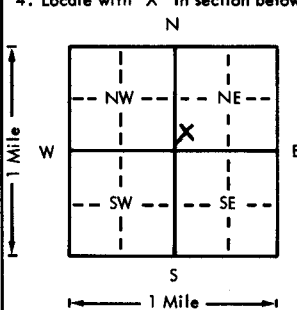


USE TYPEWRITER OR BALL
POINT PEN-PRESS FIRMLY,
PRINT CLEARLY.

WATER WELL RECORD
KSA 82a-1201-1215

Kansas Department of Health and
Environment-Division of Environment
(Water well Contractors)
Topeka, Kansas 66620


1. Location of well:		County MORTON	Fraction SW 1/4 SW 1/4 NE 1/4	Section number 12	Township number Westola T 32	Range number S 43 E 12
2. Distance and direction from nearest town or city: 19N 2 1/2 W 3 1/4 N ELKHART-KANS				3. Owner of well: EMERY STOOPS R.R. or street: 10736 LECONTE AVE City, state, zip code: LOS ANGELES CALIF. 90024		
4. Locate with "X" in section below:		Sketch map:		6. Bore hole dia. 19 in. Completion date 4-18-76 Well depth 660 ft.		
				7. <input checked="" type="checkbox"/> Cable tool <input checked="" type="checkbox"/> Rotary <input type="checkbox"/> Driven <input type="checkbox"/> Dug <input type="checkbox"/> Hollow rod <input type="checkbox"/> Jetted <input type="checkbox"/> Bored <input type="checkbox"/> Reverse rotary		
5. Type and color of material		From		To		8. Use: <input type="checkbox"/> Domestic <input type="checkbox"/> Public supply <input type="checkbox"/> Industry <input checked="" type="checkbox"/> Irrigation <input type="checkbox"/> Air conditioning <input type="checkbox"/> Stock <input type="checkbox"/> Lawn <input type="checkbox"/> Oil field water <input type="checkbox"/> Other
Top Soil		0		55		9. Casing: Material <input type="checkbox"/> Height: Above or below Threaded <input type="checkbox"/> Welded <input checked="" type="checkbox"/> Surface 15 in. RMP <input type="checkbox"/> PVC <input type="checkbox"/> Weight 42.05 lbs./ft. Dia. 16 in. to 233 ft. depth Wall Thickness: inches or Dia. 14 in. to 660 ft. depth gage No. 250
SANDROCK TAN & Silty		55		110		10. Screen: Manufacturer's name No Screen LAKEWOOD PIPE OF TEXAS Type Steel Dia. 16 " Slot/gauze 1/4" Torch Length 40 Set between 233 ft. and 660 ft. Gravel pack? <input checked="" type="checkbox"/> Size range of material 3/4
SANDROCK Red & yellow silty		110		270		11. Static water level: 60 ft. below land surface Date 4-18-76
SANDROCK Red & yellow clean		270		395		12. Pumping level below land surfaces: 450 ft. after 12 hrs. pumping 250 g.p.m. ft. after hrs. pumping g.p.m. Estimated maximum yield 250 g.p.m.
SANDROCK Red & TAN Red clay stks		395		450		13. Water sample submitted: <input type="checkbox"/> Yes <input checked="" type="checkbox"/> No Date
SANDROCK Red & CLAY Red stks Silty		450		615		14. Well head completion: <input type="checkbox"/> Pitless adapter <input type="checkbox"/> Inches above grade
SANDROCK Red & CLAY Red stks Silty		615		660		15. Well grouted? <input checked="" type="checkbox"/> Yes With: <input checked="" type="checkbox"/> Neat cement <input type="checkbox"/> Bentonite <input type="checkbox"/> Concrete Depth: From 10 ft. to 10 ft. Below
						16. Nearest source of possible contamination: None ft. Direction Type Well disinfected upon completion? <input type="checkbox"/> Yes <input checked="" type="checkbox"/> No
						17. Pump: Yes <input checked="" type="checkbox"/> Not installed Manufacturer's name WORTHINGTON PUMP Model number G 342 HP 200 Volts Length of drop pipe 620 ft. capacity 250 g.p.m. Type: <input type="checkbox"/> Submersible <input checked="" type="checkbox"/> Turbine <input type="checkbox"/> Jet <input type="checkbox"/> Reciprocating <input type="checkbox"/> Centrifugal <input type="checkbox"/> Other
18. Elevation:		19. Remarks:		20. Water well contractor's certification:		
Topography: <input checked="" type="checkbox"/> Hill <input checked="" type="checkbox"/> Slope <input type="checkbox"/> Upland <input type="checkbox"/> Valley		Concrete slab to be installed By Customer		This well was drilled under my jurisdiction and this report is true to the best of my knowledge and belief. CONTR Ralph's Irrigation Drilling Business name SPRINGFIELD Colo 81073 License No. 154 Address Ralph R. Woods Signed Ralph R. Woods Date 4-18-76 Authorized representative		

USE TYPEWRITER OR BALL
POINT PEN-PRESS FIRMLY,
PRINT CLEARLY.

WATER WELL RECORD
KSA 82a-1201-1215

T R EW sec 1/4 1/4 1/4 No.

Kansas State Dept. Of Health
(Water Well Contractors)
Forbes-Bldg. 740
Topeka, Kansas 66620

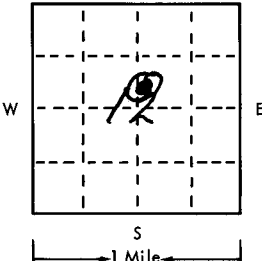1 Location of well:	County Morton	Township name Westola	Fraction SW NE 1/4	Section number 12	Town number 32	Range number 43
Distance and direction from nearest town or city: 19 North 1/2 West 3/4 North Elk Hart, Kans			3 Owner of well: EMERY STROPS Address: 10736 L'ECONTE AVE LOS ANGELES - CALIF 90024			
Locate with "X" in section below: 			Sketch map:			4 Well depth: 660 ft. Date of completion Nov 1-75 Well diameter 19 in.
2 Type and color of material			From To		5 <input type="checkbox"/> Cable tool <input checked="" type="checkbox"/> Rotary <input type="checkbox"/> Driven <input type="checkbox"/> Dug <input type="checkbox"/> Hollow rod <input type="checkbox"/> Jetted <input type="checkbox"/> Bored <input type="checkbox"/> Reverse rotary	
					6 Use: <input type="checkbox"/> Domestic <input type="checkbox"/> Public supply <input type="checkbox"/> Industry <input checked="" type="checkbox"/> Irrigation <input type="checkbox"/> Air conditioning <input type="checkbox"/> Commercial <input type="checkbox"/> Test well <input type="checkbox"/>	
Top - Clay & Gyp Rock.			0 55		7 Casing: Material 2 1/2 Height: above/below Threaded <input type="checkbox"/> Welded <input checked="" type="checkbox"/> Surface 18 in. Diam. 16 in. to 233 ft. depth Drive shoe? <input type="checkbox"/> Yes <input checked="" type="checkbox"/> No 14 in. to 660 ft. depth	
					8 Screen: Manufacturer _____ Type _____ Dia. _____ Slot/gauze _____ Length _____ Set between 233 ft. and 660 ft. Fittings: Gravel pack <input type="checkbox"/> Yes <input checked="" type="checkbox"/> No Size range of material _____	
Red & yellow - TAN S.R. Silty			110 270		9 Static water level: 60 ft. below land surface Date Nov 1-75	
Red & TAN S.R. Drills 600 DURING water			270 395		10 Pumping level below land surfaces: 450 ft. after 12 hrs. pumping 250 g.p.m. _____ ft. after _____ hrs. pumping _____ g.p.m. Estimated maximum yield 250 g.p.m.	
Red & TAN S.R. Dirty & Clay stks			395 450		11 Water sample submitted: <input type="checkbox"/> Yes <input checked="" type="checkbox"/> No Date _____	
Red S.R. HAND stks Red Clay stks			450 615		12 Well head completion: <input type="checkbox"/> Pitless adapter <input type="checkbox"/> Inches above grade	
Red S.R. HAND stks Red Clay SHALE stks			615 660		13 Well grouted? <input type="checkbox"/> Yes <input checked="" type="checkbox"/> No <input type="checkbox"/> Neat cement <input type="checkbox"/> Bentonite <input checked="" type="checkbox"/> Cemented Depth: From 1/2 ABOVE 10 ft Below ground	
					14 Nearest source of possible contamination: None ft. _____ Direction _____ Type _____ Well disinfected upon completion? <input type="checkbox"/> Yes <input type="checkbox"/> No	
					15 Pump: <input checked="" type="checkbox"/> Not installed Manufacturer's name _____ Model number _____ HP _____ Volts _____ Length of drop pipe _____ ft. capacity _____ g.p.m. Type: <input type="checkbox"/> Submersible <input type="checkbox"/> Turbine <input type="checkbox"/> Jet <input type="checkbox"/> Reciprocating <input type="checkbox"/> Centrifugal <input type="checkbox"/> Other	
(use a second sheet if needed)						
16 Remarks: elevation Topography: <input type="checkbox"/> Hill <input type="checkbox"/> Slope <input checked="" type="checkbox"/> Upland <input type="checkbox"/> Valley			17 Water well contractor's certification: This well was drilled under my jurisdiction and this report is true to the best of my knowledge and belief. Ralph's Irrigation Drilling Center Business name _____ License No. _____ Address: 1309 S. MAIN Signed: Calvin R. Woods Date 12-4-75 Authorized representative Springfield, Colo. 80703			

Forward the white, blue and pink copies to the Kansas State Dept. Of Health.

Form WW-C-5