


1 LOCATION OF WATER WELL: Fraction NE 1/4 NE 1/4 NW 1/4 Section Number 20 Township Number T 32 S Range Number R 43 E/W
 County: Montezuma

Distance and direction from nearest town or city street address of well if located within city?
1 1/2 miles west of Richfield, Kansas

2 WATER WELL OWNER: Don Frownfelter Board of Agriculture, Division of Water Resources
 RR#, St. Address, Box #: Montezuma, Kansas 67862 Application Number:
 City, State, ZIP Code:

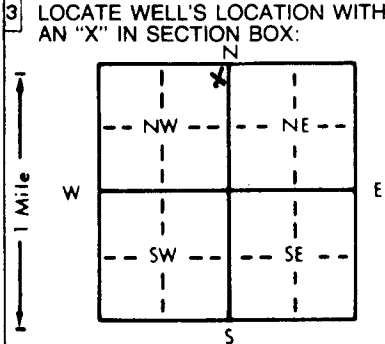

4 DEPTH OF COMPLETED WELL: 121 ft. ELEVATION: Slope
 Depth(s) Groundwater Encountered 1. 58 ft. 2. ft. 3. ft.
 WELL'S STATIC WATER LEVEL 58 ft. below land surface measured on mo/day/yr 5/27/93
 Pump test data: Well water was 68 ft. after 6 hours pumping 15 gpm
 Est. Yield 20 gpm Well water was ft. after hours pumping gpm
 Bore Hole Diameter 9 7/8 in. to 121 ft. and in. to ft.
 WELL WATER TO BE USED AS:
 Domestic 3 Feedlot 6 Oil field water supply 9 Dewatering 12 Other (Specify below)
 2 Irrigation 4 Industrial 7 Lawn and garden only 10 Monitoring well
 Was a chemical/bacteriological sample submitted to Department? Yes No If yes, mo/day/yr sample was submitted
 Water Well Disinfected? Yes No

5 TYPE OF BLANK CASING USED:
 1 Steel 3 RMP (SR) 5 Wrought iron 8 Concrete tile CASING JOINTS: Glued Clamped
 PVC 4 ABS 6 Asbestos-Cement 9 Other (specify below) riveted
 7 Fiberglass Threaded
 Blank casing diameter 5 in. to 71 ft. Dia. in. to ft. Dia. in. to ft.
 Casing height above land surface 18 in. weight Schedule 80 PVC lbs./ft. Wall thickness or gauge No.
 TYPE OF SCREEN OR PERFORATION MATERIAL:
 1 Steel 3 Stainless steel 5 Fiberglass 8 RMP (SR) 10 Asbestos-cement
 2 Brass 4 Galvanized steel 6 Concrete tile 9 ABS 11 Other (specify)
 SCREEN OR PERFORATION OPENINGS ARE:
 1 Continuous slot 3 Mill slot 5 Gauzed wrapped 8 Saw cut 11 None (open hole)
 2 Louvered shutter 4 Key punched 6 Wire wrapped 9 Drilled holes
 7 Torch cut 10 Other (specify)
 SCREEN-PERFORATED INTERVALS: From 71 ft. to 121 ft. From ft. to ft.
 From ft. to ft. From ft. to ft.
 GRAVEL PACK INTERVALS: From 24 ft. to 121 ft. From ft. to ft.
 From ft. to ft. From ft. to ft.

6 GROUT MATERIAL: 1 Neat cement 2 Cement grout 3 Bentonite 4 Other
 Grout Intervals: From 4 ft. to 24 ft. From ft. to ft. From ft. to ft.
 What is the nearest source of possible contamination:
 1 Septic tank 4 Lateral lines 7 Pit privy 10 Livestock pens 14 Abandoned water well
 2 Sewer lines 5 Cess pool 8 Sewage lagoon 11 Fuel storage 15 Oil well/Gas well
 3 Watertight sewer lines 6 Seepage pit 9 Feedyard 12 Fertilizer storage 16 Other (specify below)
 13 Insecticide storage
 Direction from well? Northwest How many feet? 300 ft

FROM	TO	LITHOLOGIC LOG	FROM	TO	PLUGGING INTERVALS
0	2	Surface			
2	30	Sandy clay			
30	55	White rock			
55	90	Clay w/ sand strips			
90	105	medium sand			
105	121	Red sandy clay w/sand strips			
121	130	Red clay			
130	168	Red Bed			

7 CONTRACTOR'S OR LANDOWNER'S CERTIFICATION: This water well was (1) constructed (2) reconstructed, or (3) plugged under my jurisdiction and was completed on (mo/day/year) 5/27/93 and this record is true to the best of my knowledge and belief. Kansas Water Well Contractor's License No. 164 This Water Well Record was completed on (mo/day/yr) June 18, 1993 under the business name of Hauck Bros. Dry Co. by (signature) M. Beard

INSTRUCTIONS Use typewriter or ball point pen. PLEASE PRESS FIRMLY and PRINT clearly. Please fill in blanks, underline or circle the correct answers. Send top three copies to Kansas Department of Health and Environment, Bureau of Water, Topeka, Kansas 66620-0001. Telephone: 913-296-5545 Send one to WATER WELL OWNER and retain one for your records.