


1 LOCATION OF WATER WELL: County: **Harper** Fraction: **SE 1/4 NE 1/4 NE 1/4** Section Number: **6** Township Number: **T 32S S** Range Number: **R 6 W**

Distance and direction from nearest town or city street address of well if located within city?
~~Ken-Kiser~~ - 1 mile east, 1/4 mile south of north edge of Harper, Kans.

2 WATER WELL OWNER: **Ken Kiser**
 RR#, St. Address, Box #: **RT#3--Box247A** Board of Agriculture, Division of Water Resources
 City, State, ZIP Code: **Harper, Kans.** Application Number:

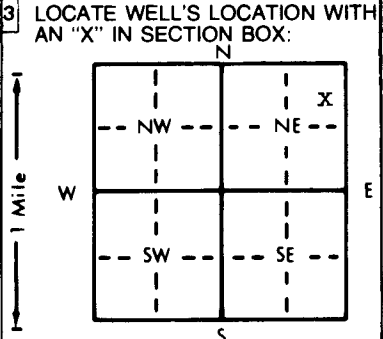

4 DEPTH OF COMPLETED WELL: **93'** ft. ELEVATION: _____ ft.
 Depth(s) Groundwater Encountered 1. **24'** ft. 2. _____ ft. 3. _____ ft.
 WELL'S STATIC WATER LEVEL **21'** ft. below land surface measured on mo/day/yr **July 27 1995**
 Pump test data: Well water was **NA** ft. after _____ hours pumping _____ gpm
 Est. Yield **30** gpm; Well water was **NA** ft. after _____ hours pumping _____ gpm
 Bore Hole Diameter: **7 7/8** in. to **93'** ft., and _____ in. to _____ ft.
 WELL WATER TO BE USED AS: 5 Public water supply 8 Air conditioning 11 Injection well
 1 Domestic 3 Feedlot 6 Oil field water supply 9 Dewatering 12 Other (Specify below)
 2 Irrigation 4 Industrial **XX** 7 Lawn and garden only 10 Monitoring well _____
 Was a chemical/bacteriological sample submitted to Department? Yes _____ No **XX** _____; If yes, mo/day/yr sample was submitted _____
 Water Well Disinfected? Yes **X** No

5 TYPE OF BLANK CASING USED: 5 Wrought iron 8 Concrete tile CASING JOINTS: Glued **X** Clamped _____
 1 Steel 3 RMP (SR) 6 Asbestos-Cement 9 Other (specify below) Welded _____
XX 2 PVC 4 ABS 7 Fiberglass Threaded _____
 Blank casing diameter **5"** in. to **79"** ft., Dia _____ in. to _____ ft., Dia _____ in. to _____ ft.
 Casing height above land surface **15"** in., weight **160** lbs./ft. Wall thickness or gauge No. **SDR 26**
 TYPE OF SCREEN OR PERFORATION MATERIAL: **XX** PVC 10 Asbestos-cement
 1 Steel 3 Stainless steel 5 Fiberglass 8 RMP (SR) 11 Other (specify) _____
 2 Brass 4 Galvanized steel 6 Concrete tile 9 ABS 12 None used (open hole)
 SCREEN OR PERFORATION OPENINGS ARE: 5 Gauzed wrapped **XX** 8 Saw cut 11 None (open hole)
 1 Continuous slot 3 Mill slot 6 Wire wrapped 9 Drilled holes
 2 Louvered shutter 4 Key punched **93'** 7 Torch cut **79'** 10 Other (specify) _____
 SCREEN-PERFORATED INTERVALS: From _____ ft. to _____ ft., From _____ ft. to _____ ft.
 From _____ ft. to _____ ft., From _____ ft. to _____ ft.
 GRAVEL PACK INTERVALS: From **93'** ft. to **72'** ft., From _____ ft. to _____ ft.
 From **60'** ft. to **24'** ft., From _____ ft. to _____ ft.

6 GROUT MATERIAL: 1 Neat cement 2 Cement grout **XX** 3 Bentonite 4 Other _____
 Grout Intervals: From **72'** ft. to **60'** ft., From **24'** ft. to **3'** ft., From _____ ft. to _____ ft.
 What is the nearest source of possible contamination:
XX 1 Septic tank 4 Lateral lines 7 Pit privy 10 Livestock pens 14 Abandoned water well
 2 Sewer lines 5 Cess pool 8 Sewage lagoon 11 Fuel storage 15 Oil well/Gas well
 3 Watertight sewer lines 6 Seepage pit 9 Feedyard 12 Fertilizer storage 16 Other (specify below)
 13 Insecticide storage _____
 Direction from well? **south** How many feet? **App. 140'**

FROM	TO	LITHOLOGIC LOG	FROM	TO	PLUGGING INTERVALS
0'	2'	Top soil.			
2'	4'	clay.			
4'	6'	clay.			
6'	10'	sandy clay.			
10'	21'	clay.			
21'	30'	course sand.			
30'	49'	clay.			
49'	60'	Course sand.			
60'	70'	course sand.			
70'	71'	clay strip.			
71'	91'	very course GRAVEL.			
91'	93'	Red Bed.			

7 CONTRACTOR'S OR LANDOWNER'S CERTIFICATION: This water well was (1) constructed, (2) reconstructed, or (3) plugged under my jurisdiction and was completed on (mo/day/year) **July 27, 1995** and this record is true to the best of my knowledge and belief. Kansas Water Well Contractor's License No. **112** This Water Well Record was completed on (mo/day/yr) **Aug. 26 1995** under the business name of **Wells Drilling Co.** by (signature) *Hal Wells*

OFFICE USE ONLY
T
R
EW
SEC.
1/4
1/4
1/4