


1 LOCATION OF WATER WELL: County: Harper	Fraction NW 1/4 SW 1/4 SW 1/4	Section Number 3	Township Number T 32 S	Range Number R 6 E/W
---	----------------------------------	---------------------	---------------------------	-------------------------

Distance and direction from nearest town or city street address of well if located within city?
Approximately 3 miles east of Harper

2 WATER WELL OWNER: Randy Blanchat
 RR#, St. Address, Box #: Route 1 - Box 51A
 City, State, ZIP Code: Danville, KS 67036
 Board of Agriculture, Division of Water Resources
 Application Number: 39,815 & 39,816

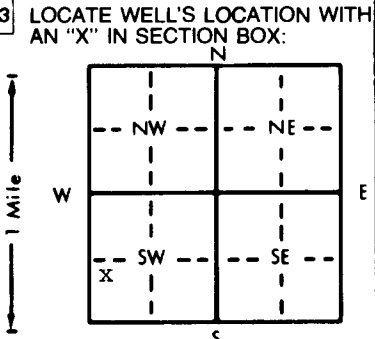

4 DEPTH OF COMPLETED WELL: 51 ft. ELEVATION: unknown

Depth(s) Groundwater Encountered 1. ft. 2. ft. 3. ft.

WELL'S STATIC WATER LEVEL . . . 7 . . . ft. below land surface measured on mo/day/yr . . . 8-31-93

Pump test data: Well water was not ch'd. ft. after hours pumping gpm

Est. Yield unknown gpm: Well water was ft. after hours pumping gpm

Bore Hole Diameter. . . 24 . . . in. to . . . 50 . . . ft., and in. to ft.

WELL WATER TO BE USED AS:

5 Public water supply	8 Air conditioning	11 Injection well
1 Domestic	3 Feedlot	6 Oil field water supply
2 Irrigation	4 Industrial	7 Lawn and garden only
		9 Dewatering
		10 Monitoring well
		12 Other (Specify below)

Was a chemical/bacteriological sample submitted to Department? Yes. No. X.; If yes, mo/day/yr sample was submitted

Water Well Disinfected? Yes No X

5 TYPE OF BLANK CASING USED:

1 Steel	3 RMP (SR)	6 Asbestos-Cement	9 Other (specify below)
2 PVC	4 ABS	7 Fiberglass	

Blank casing diameter . . . 16 . . . in. to . . . 30 . . . ft., Dia. in. to ft., Dia. in. to ft.

Casing height above land surface. 12 . . . in., weight 36, 86 . . . lbs./ft. Wall thickness or gauge No. . . . 219

CASING JOINTS: Glued Clamped
 Welded . . . X.
 Threaded

TYPE OF SCREEN OR PERFORATION MATERIAL:

1 Steel	3 Stainless steel	5 Fiberglass	8 RMP (SR)	11 Other (specify)
2 Brass	4 Galvanized steel	6 Concrete tile	9 ABS	12 None used (open hole)

SCREEN OR PERFORATION OPENINGS ARE:

1 Continuous slot	3 Mill slot	6 Wire wrapped	9 Drilled holes
2 Louvered shutter	4 Key punched	7 Torch cut	10 Other (specify) .. Bridge Slot
		5 Gauzed wrapped	8 Saw cut
			11 None (open hole)

SCREEN-PERFORATED INTERVALS: From . . . 30 . . . ft. to . . . 50 . . . ft., From ft. to ft.

GRAVEL PACK INTERVALS: From . . . 21 . . . ft. to . . . 50 . . . ft., From ft. to ft.

6 GROUT MATERIAL: 1 Neat cement 2 Cement grout 3 Bentonite 4 Other

Grout intervals: From . . . 0 . . . ft. to . . . 21 . . . ft., From ft. to ft., From ft. to ft.

What is the nearest source of possible contamination:

1 Septic tank	4 Lateral lines	7 Pit privy	10 Livestock pens	14 Abandoned water well
2 Sewer lines	5 Cess pool	8 Sewage lagoon	11 Fuel storage	15 Oil well/Gas well
3 Watertight sewer lines	6 Seepage pit	9 Feedyard	12 Fertilizer storage	16 Other (specify below)
			13 Insecticide storage	None known

Direction from well? How many feet?

FROM	TO	LITHOLOGIC LOG	FROM	TO	PLUGGING INTERVALS
0	2	Topsoil			
2	15	Clay, red			
15	18	Sand, fine mixed clay			
18	23	Clay, red			
23	24	Sand, fine			
24	25	Clay, red			
25	45	Sand and gravel, fine, medium, clay streak at 32'			
45	50	Sand and gravel, fine, medium, some coarse			

7 CONTRACTOR'S OR LANDOWNER'S CERTIFICATION: This water well was (1) constructed, (2) reconstructed, or (3) plugged under my jurisdiction and was completed on (mo/day/year) . . . 8-31-93 . . . and this record is true to the best of my knowledge and belief. Kansas Water Well Contractor's License No. . . . 185 . . . This Water Well Record was completed on (mo/day/yr) . . . 9-22-93 . . . under the business name of Clarke Well & Equipment, Inc. by (signature) *Clarke Well & Equipment, Inc.*

OFFICE USE ONLY
T
R
E/W
SEC.
1/4
1/4
1/4