

USE TYPEWRITER OR BALL POINT PEN-PRESS FIRMLY, PRINT CLEARLY.

WATER WELL RECORD
KSA 82a-1201-1215


T R EW sec 1/4 1/4 1/4 No.

Kansas State Dept. Of Health
(Water Well Contractors)
Forbes-Bldg. 740
Topeka, Kansas 66620

1 Location of well: County **HARDER** Township name **W E YUB** Fraction **N 1/4 NE 1/4** Section number **6** Town number **325** Range number **R 6 W**

Distance and direction from nearest town or city: **1/2 MI. E OF HARDER** Owner of well: **HENRY AIPHIN**

Street address of well location if in city: _____ Address: **RAGO, KS**

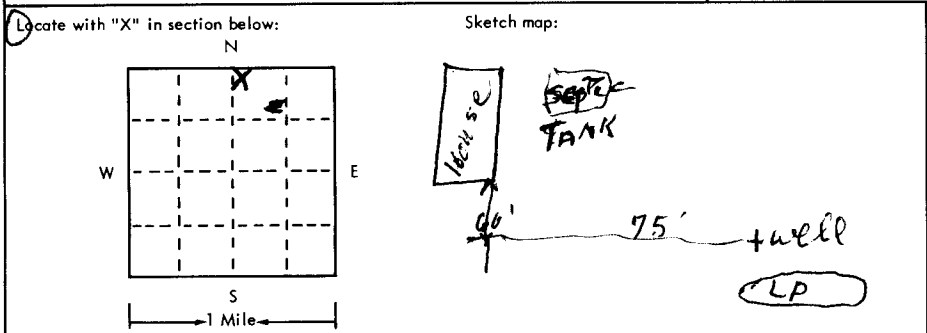

4 Well depth: **96** ft. Date of completion: **1-14-75**
Well diameter: **8** in.

5 Cable tool Rotary Driven Dug
 Hollow rod Jetted Bored Reverse rotary

6 Use: Domestic Public supply Industry
 Irrigation Air conditioning Commercial
 Test well

7 Casing: Material **PVC** Height: above/below
Threaded Welded Surface _____ in.
Diam. _____ Weight _____ lbs./ft. _____
4 in. to **96** ft. depth Drive shoe? Yes No
_____ in. to _____ ft. depth

2	Type and color of material	From	To
	Clay	0	16
	SANDY CLAY	16	21
	SAND	21	24
	Clay	25	50
	MED & COARSE SAND	50	72
	Clay & Mud	72	87
	MED SAND	87	94
	Red Shale	94	96

8 Screen: Manufacturer **Peerless**
Type **PVC** Dia. **4"**
Slot/gauze **0.55** Length **10'**
Set between **91** ft. and **94** ft.
Fittings: **71** **76**
Gravel pack Yes No Size range of material _____

9 Static water level: **25** ft. below land surface Date **1-13-75**

10 Pumping level below land surfaces:
_____ ft. after _____ hrs. pumping _____ g.p.m.
_____ ft. after _____ hrs. pumping _____ g.p.m.
Estimated maximum yield **50** g.p.m.

11 Water sample submitted:
 Yes No Date _____

12 Well head completion:
 Pitless adapter **20** inches above grade

13 Well grouted? Yes No
 Neat cement Bentonite _____
Depth: From **3** ft. to **15** ft.

14 Nearest source of possible contamination: **SEPTIC**
ft. **100** Direction **N** Type **TANK**
Well disinfected upon completion? Yes No

15 Pump: Not installed
Manufacturer's name **JACUZZI**
Model number **554B** HP **1/2** Volts **30**
Length of drop pipe **63** ft. capacity **10** g.m.p.
Type:
 Submersible Turbine
 Jet Reciprocating
 Centrifugal Other

16 Remarks: elevation

Topography:
 Hill
 Slope
 Upland
 Valley

TOP SLAB WILL BE PLACED BY CUSTOMER

17 Water well contractor's certification:
This well was drilled under my jurisdiction and this report is true to the best of my knowledge and belief.
LYMAN BROS **140**
Business name License No.
Address **W H**
Signed **W H Lyman** Date **1-14-75**
Authorized representative

3260 WYBUNE NE