


WATER WELL RECORD Form WWC-5 KSA 82a-1212

1 LOCATION OF WATER WELL: Harper	FRACTION SE 1/4 SW 1/4 SE 1/4	SECTION NUMBER 1	TOWNSHIP NUMBER T 32 S	RANGE NUMBER R 7W E/W
--	----------------------------------	----------------------------	----------------------------------	---------------------------------

Distance and direction from nearest town or city street address of well if located within city?
3.3 miles West of Hwy 14 & Hwy 160, West edge of Town on North side Harper, Kansas

2 WATER WELL OWNER: BELL, Don RR#, ST. ADDRESS, BOX #: 312 E. 13th CITY, STATE: Harper, Kansas	Board of Agriculture, Division of Water Resource Application Number: _____
---	---

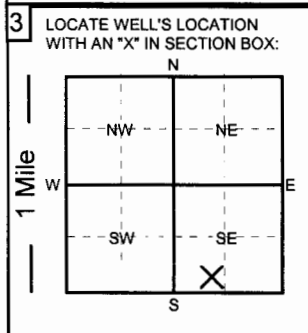

4 DEPTH OF COMPLETED WELL: 100 ft. ELEVATION: _____ ft.	
Depth of groundwater Encountered: _____ ft.	
WELL'S STATIC WATER LEVEL 10 FT. BELOW LAND SURFACE MEASURED ON 9/9/04 mo/day/yr:	
Pump test data:	Well water was _____ ft. after _____ hours of pumping @ _____ gpm
Est. Yield: _____ gpm	Well water was _____ ft. after _____ hours of pumping @ _____ gpm
Bore Hole Diameter 12 in.	to 100 ft. and _____ in. to _____ ft.
WELL WATER TO BE USED AS:	
<input checked="" type="checkbox"/> 1. Domestic <input type="checkbox"/> 3. Feedlot <input type="checkbox"/> 5. Public water supply <input type="checkbox"/> 7. Lawn and garden only <input type="checkbox"/> 9. Dewatering <input type="checkbox"/> 11. Injection well	
<input type="checkbox"/> 2. Irrigation <input type="checkbox"/> 4. Industrial <input type="checkbox"/> 6. Oil field water supply <input type="checkbox"/> 8. Air conditioning <input type="checkbox"/> 10. Monitoring well <input type="checkbox"/> 12. Other (Specify below)	
Was a chemical/bacteriological sample submitted to Department? YES _____ NO <input checked="" type="checkbox"/>	
Was Water Well Disinfected? <input checked="" type="checkbox"/> YES _____ NO	

5 TYPE OF CASING USED:		5. Wrought Iron		7. Fiberglass		9. Other (Specify below)		CASING JOINTS: <input checked="" type="checkbox"/> Glued _____ Threaded	
<input type="checkbox"/> 1. Steel <input checked="" type="checkbox"/> 2. PVC <input type="checkbox"/> 3. RPM (SR) <input type="checkbox"/> 4. ABS <input type="checkbox"/> 6. Asbestos-Cement <input type="checkbox"/> 8. Concrete tile		SDR-26						Welded _____ Clamped	
Blank casing diameter 5 in.		to 25 ft., Dia.		in. to _____ ft., Dia.		in. to _____ ft.			
Casing height above land surface: 12 in.,		Weight: 2.35 lbs. / ft.		Wall thickness or gauge No. .214					
TYPE OF SCREEN OR PERFORATION MATERIAL:									
<input type="checkbox"/> 1. Steel <input type="checkbox"/> 3. Stainless Steel <input type="checkbox"/> 5. Fiberglass <input checked="" type="checkbox"/> 7. PVC <input type="checkbox"/> 9. ABS <input type="checkbox"/> 11. Other (specify)									
<input type="checkbox"/> 2. Brass <input type="checkbox"/> 4. Galvanized <input type="checkbox"/> 6. Concrete Tile <input type="checkbox"/> 8. RMP (SR) <input type="checkbox"/> 10. Asbestos-Cement <input type="checkbox"/> 12. None used (open hole)									
SCREEN OR PERFORATION OPENINGS ARE:									
<input type="checkbox"/> 1. Continuous slot <input type="checkbox"/> 3. Mill slot <input type="checkbox"/> 5. Gauzed wrapped <input type="checkbox"/> 7. Torch cut <input type="checkbox"/> 9. Drilled holes <input type="checkbox"/> 11. None (open hole)									
<input type="checkbox"/> 2. Louvered shutter <input type="checkbox"/> 4. Key punched <input type="checkbox"/> 6. Wire wrapped <input checked="" type="checkbox"/> 8. Saw cut <input type="checkbox"/> 10. Other (specify)									
SCREEN - PERFORATION INTERVAL									
From 24 ft.		to 100 ft.,		From _____ ft.		to _____ ft.		to _____ ft.	
From _____ ft.		to _____ ft.,		From _____ ft.		to _____ ft.		to _____ ft.	
GRAVEL PACK INTERVALS:									
From 24 ft.		to 100 ft.,		From _____ ft.		to _____ ft.		to _____ ft.	
From _____ ft.		to _____ ft.,		From _____ ft.		to _____ ft.		to _____ ft.	

6 GROUT MATERIALS:		1. Neat cement		2. Cement Grout		3. Bentonite		Other bentonite hole plug	
Grout Intervals: From 4 ft.		to 24 ft.,		From _____ ft.		to _____ ft.		From _____ ft. to _____ ft.	
What is the nearest source of possible contamination:									
<input type="checkbox"/> 1. Septic tank <input type="checkbox"/> 4. Lateral lines <input type="checkbox"/> 7. Pit privy <input type="checkbox"/> 10. Livestock pens <input type="checkbox"/> 13. Insecticide storage <input type="checkbox"/> 15. Oil well/Gas well									
<input type="checkbox"/> 2. Sewer lines <input type="checkbox"/> 5. Cess Pool <input type="checkbox"/> 8. Sewage lagoon <input type="checkbox"/> 11. Fuel storage <input type="checkbox"/> 14. Abandon water well <input type="checkbox"/> 16. Other (specify below)									
<input type="checkbox"/> 3. Watertight sewer line <input type="checkbox"/> 6. Seepage pit <input type="checkbox"/> 9. Feed yard <input type="checkbox"/> 12. Fertilizer storage									
Direction from well?									How many feet?

From	To	LITHOLOGIC LOG	From	To	LITHOLOGIC LOG
0	8	fine sand			
8	100	red shale			

RECEIVED
OCT 04 2004
BUREAU OF WATER

7 Contractor's or Landowner's Certification: This water well was 1. <input checked="" type="checkbox"/> constructed 2. <input type="checkbox"/> reconstructed or 3. <input type="checkbox"/> plugged under my jurisdiction and was completed on (mo/day/year) 9/9/2004 and this record is true to the best of my knowledge and belief.	
Kansas Water Well Contractor's License No. 236	This water well record was completed on (mo/day/year) 9/13/2004
under the business name of Harp Well & Pump Service Inc.	by (signature) <i>J o d d S. Harp</i>