


1 LOCATION OF WATER WELL: Fraction NE 1/4 NW 1/4 NE 1/4 Section Number 12 Township Number T 32 S Range Number R 7 EW

Distance and direction from nearest town or city street address of well if located within city? 103 W. 14th St., Harper

2 WATER WELL OWNER: Kansas Dept. of Health & Environment

RR#, St. Address, Box #: 1000 SW Jackson, Suite 410 Board of Agriculture, Division of Water Resources
City, State, ZIP Code: Topeka, Kansas 66612-1367 Application Number:

3 LOCATE WELL'S LOCATION WITH AN "X" IN SECTION BOX:

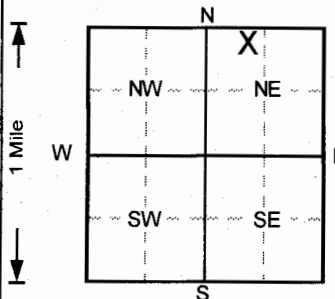

4 DEPTH OF COMPLETED WELL: 18 ft. ELEVATION: 1419.62
WELL'S STATIC WATER LEVEL: 5.81 ft. below land surface measured on 4/27/2009
Pump test data: Well water was NA ft. after hours pumping
Est. Yield: NA gpm
WELL WATER TO BE USED AS: 10 Monitoring well
Was a chemical/bacteriological sample submitted to Department? Yes No
Water Well Disinfected? Yes No

5 TYPE OF BLANK CASING USED: 2 PVC, 2 RMP (SR), 3 Wrought iron, 8 Concrete tile
Blank casing diameter: 2 in. Dia: 8 in. Wall thickness or gauge No. Sch. 40
CASING JOINTS: Threaded

TYPE OF SCREEN OR PERFORATION MATERIAL: 7 PVC, 10 Asbestos-cement
SCREEN OR PERFORATION OPENINGS ARE: 3 Mill slot, 8 Saw cut, 11 None (open hole)

SCREEN-PERFORATED INTERVALS: From 8 ft. to 18 ft.
GRAVEL PACK INTERVALS: From 7 ft. to 18 ft.

6 GROUT MATERIAL: 2 Cement grout, 3 Bentonite
Grout Intervals: From 0 ft. to 1 ft., From 1 ft. to 7 ft.
What is the nearest source of possible contamination: 10 Livestock pens, 14 Abandoned water well

Table with columns: FROM, TO, LITHOLOGIC LOG, FROM, TO, PLUGGING INTERVALS. Rows describe soil layers: Clay, silty, sl. sandy, Dark Brown; Clay, v. sandy, Brown; Clay, v. silty, sandy, Brown; Clay, v. sandy, Brown.

7 CONTRACTOR'S OR LANDOWNER'S CERTIFICATION: This water well was (1) constructed, (2) reconstructed, or (3) plugged under my jurisdiction and was completed on 4/22/2009 and this record is true to the best of my knowledge and belief.
Kansas Water Well Contractor's License No. 527. This Water Well Record was completed on 5/11/2009 under the business name of GeoCore, Inc. by (signature)