


1 LOCATION OF WATER WELL: County: Harper Fraction: NW 1/4 NE 1/4 NE 1/4 Section Number: 12 Township Number: T 32 S Range Number: R 7 E (W)

Distance and direction from nearest town or city street address of well if located within city?
203 East 14th, Harper, KS.

2 WATER WELL OWNER: Anthony Farmers Coop
 RR#, St. Address, Box #: 203 E. 14th
 City, State, ZIP Code: Harper, KS.
 Board of Agriculture, Division of Water Resources
 Application Number: _____

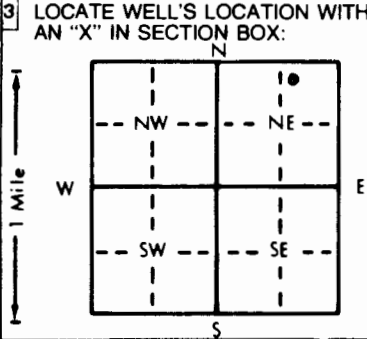

4 DEPTH OF COMPLETED WELL: 25' ft. ELEVATION: _____ ft.
 Depth(s) Groundwater Encountered: 1.8' ft. 2. _____ ft. 3. _____ ft.
 WELL'S STATIC WATER LEVEL: 13.56 ft. below land surface measured on mo/day/yr 1-29-98
 Pump test data: Well water was _____ ft. after _____ hours pumping _____ gpm
 Est. Yield _____ gpm; Well water was _____ ft. after _____ hours pumping _____ gpm
 Bore Hole Diameter: 8 1/2" in. to 25" in. to _____ in. to _____ in. to _____ ft.
 WELL WATER TO BE USED AS:
 5 Public water supply 8 Air conditioning 11 Injection well
 1 Domestic 3 Feedlot 6 Oil field water supply 9 Dewatering 12 Other (Specify below)
 2 Irrigation 4 Industrial 7 Lawn and garden only 10 Monitoring well
 Was a chemical/bacteriological sample submitted to Department? Yes _____ No X; If yes, mo/day/yr sample was submitted _____
 Water Well Disinfected? Yes _____ No (No)

5 TYPE OF BLANK CASING USED:
 1 Steel 3 RMP (SR) 5 Wrought iron 8 Concrete tile CASING JOINTS: Glued _____ Clamped _____
2 PVC 4 ABS 7 Fiberglass _____ Welded _____
 Blank casing diameter 2.375 in. to 10' ft., Dia _____ in. to _____ ft., Dia _____ in. to SDR 13 ft.
 Casing height above land surface Flush Mt. in., weight _____ lbs./ft. Wall thickness or gauge No. SCH 40
 TYPE OF SCREEN OR PERFORATION MATERIAL:
 1 Steel 3 Stainless steel 5 Fiberglass 8 RMP (SR) 10 Asbestos-cement 11 Other (specify) _____
 2 Brass 4 Galvanized steel 6 Concrete tile 9 ABS 12 None used (open hole)
 SCREEN OR PERFORATION OPENINGS ARE:
 1 Continuous slot 3 Mill slot 5 Gauzed wrapped 8 Saw cut 11 None (open hole)
 2 Louvered shutter 4 Key punched 6 Wire wrapped 9 Drilled holes
 7 Torch cut 10 Other (specify) _____
 SCREEN-PERFORATED INTERVALS: From 25' ft. to 10' ft., From _____ ft. to _____ ft.
 From _____ ft. to _____ ft., From _____ ft. to _____ ft.
 GRAVEL PACK INTERVALS: From 25' ft. to 8' ft., From _____ ft. to _____ ft.
 From _____ ft. to _____ ft., From _____ ft. to _____ ft.

6 GROUT MATERIAL: 1 Neat cement 2 Cement grout 3 Bentonite 4 Other _____
 Grout Intervals: From 8' ft. to 3' ft., From 3' ft. to 0' ft., From _____ ft. to _____ ft.
 What is the nearest source of possible contamination:
 1 Septic tank 4 Lateral lines 7 Pit privy 10 Livestock pens 14 Abandoned water well
 2 Sewer lines 5 Cess pool 8 Sewage lagoon 11 Fuel storage Foxcel 15 Oil well/Gas well
 3 Watertight sewer lines 6 Seepage pit 9 Feedyard 12 Fertilizer storage 16 Other (specify below) _____
 13 Insecticide storage
 Direction from well? In Tank Pit How many feet? 0

FROM	TO	LITHOLOGIC LOG	FROM	TO	PLUGGING INTERVALS
0	.75	Concrete			
.75	8	Red fine-coarse sand, dry, no odor.			
8	12	Gray clay, mod. odor, damp, firm to stiff.			
12	18	Red brn clay, moist, firm.			
18	21	Gray brn clay w/ caliche, moist to wet, soft, mod. odor.			
21	22.5	Red brn sand lens, wet, mod. odor, fine-coarse.			Fl. mt. OK'd by Don Taylor
22.5	25	Red brn clay w/ sand, soft, moist to wet.			

7 CONTRACTOR'S OR LANDOWNER'S CERTIFICATION: This water well was (1) constructed (2) reconstructed, or (3) plugged under my jurisdiction and was completed on (mo/day/year) 1-27-98 and this record is true to the best of my knowledge and belief. Kansas Water Well Contractor's License No. 539 This Water Well Record was completed on (mo/day/yr) 2-14-98 under the business name of JB Environmental by (signature) James Becker

OFFICE USE ONLY T R E W SEC. 1/4 1/4 1/4 1/4