


1 LOCATION OF WATER WELL: Fraction ~~NESE 1/4~~ ~~SW 1/4~~ ~~NESE 1/4~~ Section Number 12 Township Number T 32 S Range Number R 7W ~~5W~~  
 County: HARPER Distance and direction from nearest town or city street address of well if located within city?

305 West 22ND ST. HARPER, Kansas 67508

2 WATER WELL OWNER: LOIS NYE Trust  
 RR#, St. Address, Box # : Board of Agriculture, Division of Water Resources  
 City, State, ZIP Code : 305 West 22nd St. Harper, Kns. 67508 Application Number:

3 LOCATE WELL'S LOCATION WITH AN "X" IN SECTION BOX:

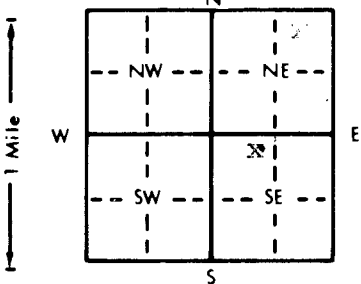

4 DEPTH OF COMPLETED WELL: 76' ft. ELEVATION:  
 Depth(s) Groundwater Encountered 1. 28' ft. 2. ft. 3. ft.  
 WELL'S STATIC WATER LEVEL: 27' ft. below land surface measured on mo/day/yr FEB. 24, 1998  
 Pump test data: Well water was ft. after hours pumping gpm  
 Est. Yield: 35 gpm; Well water was ft. after hours pumping gpm  
 Bore Hole Diameter: 8 1/2" in. to 7.6 ft. and in. to ft.  
 WELL WATER TO BE USED AS:  
 5 Public water supply 8 Air conditioning 11 Injection well  
 1 Domestic 3 Feedlot 6 Oil field water supply 9 Dewatering 12 Other (Specify below)  
 2 Irrigation 4 Industrial  Lawn and garden only 10 Monitoring well  
 Was a chemical/bacteriological sample submitted to Department? Yes No ; If yes, mo/day/yr sample was submitted  
 Water Well Disinfected? Yes  No

5 TYPE OF BLANK CASING USED:  
 1 Steel 3 RMP (SR) 5 Wrought iron 8 Concrete tile CASING JOINTS: Glued  Clamped  
 PVC 4 ABS 6 Asbestos-Cement 9 Other (specify below) Welded  
 7 Fiberglass Threaded  
 Blank casing diameter: 5 in. to 6.6 ft., Dia. in. to ft., Dia. in. to ft.  
 Casing height above land surface: 16 in., weight: 2.34 lbs./ft. Wall thickness or gauge No.: 2.48  
 TYPE OF SCREEN OR PERFORATION MATERIAL:  
 1 Steel 3 Stainless steel 5 Fiberglass  7 PVC 10 Asbestos-cement  
 2 Brass 4 Galvanized steel 6 Concrete tile 8 RMP (SR) 11 Other (specify)  
 9 ABS 12 None used (open hole)  
 SCREEN OR PERFORATION OPENINGS ARE:  
 1 Continuous slot 3 Mill slot 5 Gauzed wrapped  8 Saw cut 11 None (open hole)  
 2 Louvered shutter 4 Key punched 6 Wire wrapped 9 Drilled holes  
 7 Torch cut 10 Other (specify)  
 SCREEN-PERFORATED INTERVALS: From 76' ft. to 66' ft., From ft. to ft.  
 From ft. to ft., From ft. to ft.  
 GRAVEL PACK INTERVALS: From 76' ft. to 28' ft., From ft. to ft.  
 From ft. to ft., From ft. to ft.

6 GROUT MATERIAL: 1 Neat cement 2 Cement grout  8 Bentonite 4 Other  
 Grout Intervals: From 28' ft. to 3' ft., From ft. to ft., From ft. to ft.  
 What is the nearest source of possible contamination:  
 1 Septic tank 4 Lateral lines 7 Pit privy 10 Livestock pens 14 Abandoned water well  
 Sewer lines 5 Cess pool 8 Sewage lagoon 11 Fuel storage 15 Oil well/Gas well  
 3 Watertight sewer lines 6 Seepage pit 9 Feedyard 12 Fertilizer storage 16 Other (specify below)  
 13 Insecticide storage  
 Direction from well? East How many feet? 65'

FROM	TO	LITHOLOGIC LOG	FROM	TO	PLUGGING INTERVALS
0'	3'	Dark Top Soil.			
3'	27'	Clay.			
27'	29'	Sandy Clay.			
29'	34'	Sandy Clay.			
34'	46'	Brown Clay.			
46'	54'	Sandy Clay.			
54'	61'	Medium Course Sand W/clay strips.			
61'	76'	Course Sand & Fine Gravel.			
76'	78'	Red Bed.			

7 CONTRACTOR'S OR LANDOWNER'S CERTIFICATION: This water well was (1) constructed, (2) reconstructed, or (3) plugged under my jurisdiction and was completed on (mo/day/year) Feb. 24, 1998 and this record is true to the best of my knowledge and belief. Kansas Water Well Contractor's License No. 112 This Water Well Record was completed on (mo/day/yr) Mar. 17, 1998 under the business name of Wells Drilling Co. by (signature) *Sal Wells*

OFFICE USE ONLY T R EW SEC 1/4 1/4 1/4