

WATER WELL PLUGGING RECORD Form WWC-5P KSA 82a-1212 ID NO.

MW10


1 LOCATION OF WATER WELL: County: HARPER Fraction: 1/4 NE 1/4 NE 1/4 NE 1/4 Section Number: 12 Township Number: T 32 S Range Number: 7 [ ] E [X] W

Street/Rural Address of Well Location; if unknown, distance & direction from nearest town or intersection: If at owner's address, check here [ ] 423 E 14th St., Harper, KS

Global Positioning Systems (GPS) information: Latitude: NA (in decimal degrees) Longitude: NA (in decimal degrees) Elevation: NA Horizontal Datum: [ ] WGS84, [ ] NAD83, [ ] NAD27 Collection Method:

2 WATER WELL OWNER: Ron's Service RR#, St. Address, Box #: 423 E 14th City, State ZIP Code: Harper KS 67058

GPS unit (Make/model): Digital Map/Photo, Topographic Map, Land Survey Est. Accuracy: [ ] <3 m, [ ] 3-5 m, [ ] 5-15 m, [ ] >15 m

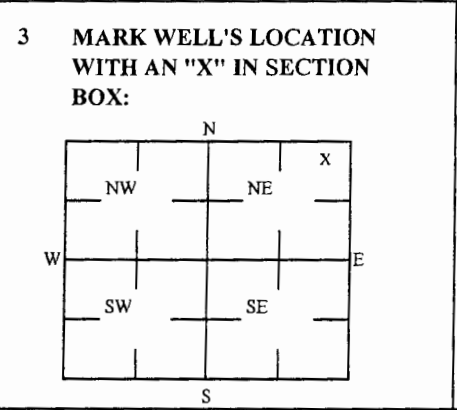

4 DEPTH OF WELL 24.2 ft. WELL'S STATIC WATER LEVEL NA ft. WELL WAS USED AS: [ ] Domestic [ ] Irrigation [ ] Feedlot [ ] Industrial [ ] Public Water Supply [ ] Oil Field Water Supply [ ] Domestic (Lawn & Garden) [ ] Air Conditioning [ ] Dewatering [X] Monitoring [ ] Injection Well [ ] Other Was a chemical/bacteriological sample submitted to Department? Yes [ ] No [X]

5 TYPE OF BLANK CASING USED: [ ] Steel [X] PVC [ ] RMP (SR) [ ] ABS [ ] Wrought [ ] Asbestos-Cement [ ] Fiberglass [ ] Concrete Tile [ ] Other (Specific below) Blank casing diameter 2 in. Was casing pulled? Yes [X] No [ ] If yes, how much 3' Casing height above or below land surface NA in.

6 GROUT PLUG MATERIAL: [ ] Neat cement [ ] Cement grout [X] Bentonite [X] Other Soil: 0.4-3' Grout Plug Intervals: From 3 ft to 24.2 ft, From \_\_\_ ft to \_\_\_ ft, From \_\_\_ ft to \_\_\_ ft. What is the nearest source of possible contamination: [ ] Septic tank [ ] Sewer lines [ ] Watertight sewer lines [ ] Lateral lines [ ] Cess pool [ ] Seepage pit [ ] Pit privy [ ] Sewage lagoon [ ] Feed yard [ ] Livestock pens [ ] Fuel storage [ ] Fertilizer storage [ ] Insecticide storage [ ] Abandoned water well [ ] Oil well/Gas well [ ] Other (specify below) Direction from well? How many feet?

Table with columns: FROM, TO, PLUGGING MATERIALS. Row 1: FROM 0, TO 3, PLUGGING MATERIALS Soil. Row 2: FROM 3, TO 24.2, PLUGGING MATERIALS Bentonite. Row 3: FROM, TO, PLUGGING MATERIALS. Row 4: FROM, TO, PLUGGING MATERIALS. Row 5: FROM, TO, PLUGGING MATERIALS. KDHE ID: KDHE ID: Ron's Service; U2-039-12937

7 CONTRACTOR'S OR LANDOWNER'S CERTIFICATION: This water well was plugged under my jurisdiction and was completed on (mo/day/year) 12/8/2016 and this record is true to the best of my knowledge and belief. Kansas Water Contractor's License No. 757. This Water Well Record was completed on (mo/day/year) 1/25/2017 under the business name of Larsen & Associates, Inc. By (signature)

Send one white copy to Kansas Department of Health & Environment, Geology Section, 1000 SW Jackson Street, Ste. 420, Topeka, KS 66612-1367. Send one copy to WATER WELL OWNER and retain one for your records. Visit us at http://www.kdheks.gov/waterwell/index.html Telephone 785-296-5524.