



NOTE: Figures exhibited within this report are only to be used within the context of this report. Placement of property lines, wells, structures, and roads is based on the available information from county appraiser maps, surveys, site visits, and/or previous vendor reports and should be considered approximate.

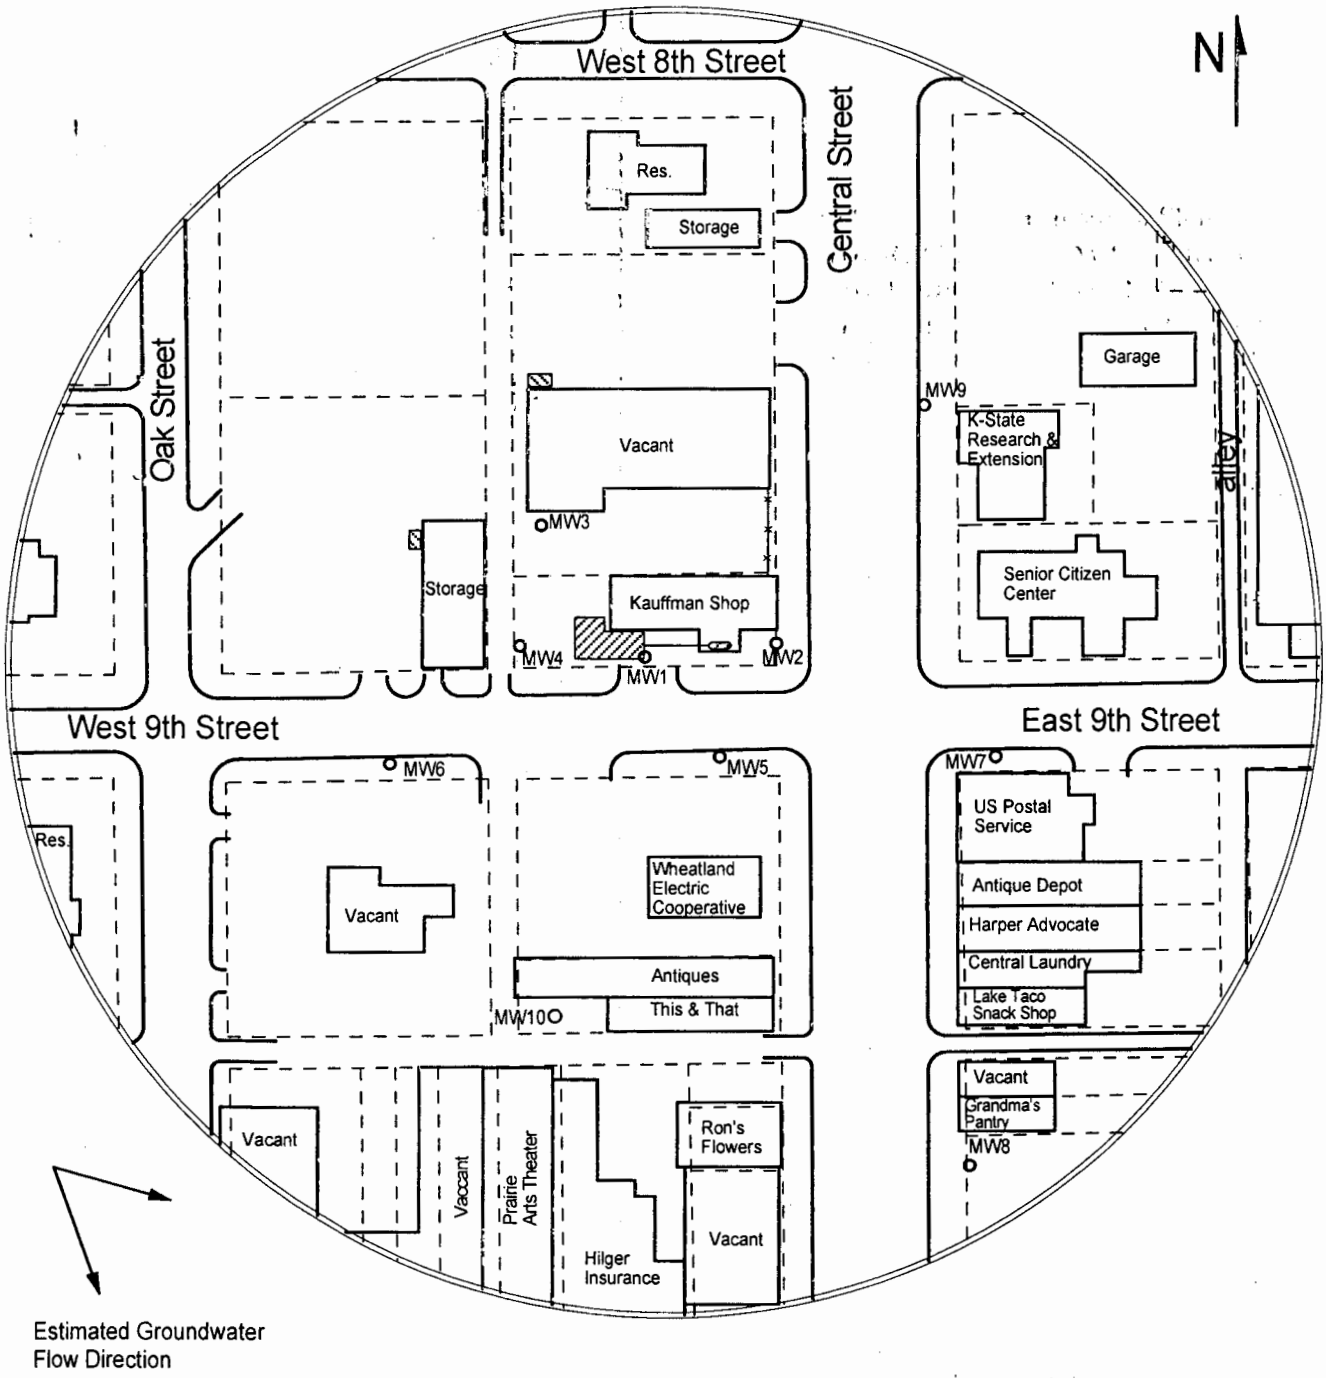


FIGURE 1 - 350 FT RADIUS AREA BASE MAP



1311 E 25th St. Suite B  
Lawrence, KS 66046

785-841-8707 office  
785-865-4282 fax

**PROJECT:**  
 Kauffman Shop  
 102 W. 9th  
 Harper, KS  
 KDHE ID: U2-039-13035  
 Date: 11/22/22



**LEGEND:**

- Approximate Location of Former UST Basin, Product Lines & Pump Island
- Approximate Location of Active ASTs
- Approximate Location of Property Line
- Plugged Monitoring Well

NOTE: Utility depths, heights and locations are approximate.