USE TYPEWRITER OR BALL POINT PEN-PRESS FIRMLY, PRINT CLEARLY.

T R EW sec 1/4 1/4 1/4 No.

WATER WELL RECORD
KSA 82a-1201-1215

Kansas State Dept. Of Health
(Water Well Contractors)
Forbes-Bldg. 740
Topeka, Kansas 66620

1 Location of well:	County	Township name	Fraction	Section number	Town number	Range number
	Harper	Township	SW 1/4	23	32	9

Distance and direction from nearest town or city: 2 miles West attica Kansas
Street address of well location if in city:

3 Owner of well: Marion Cox
Address: attica Kansas 67009

Locate with "X" in section below:

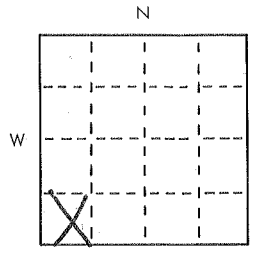

Sketch map:

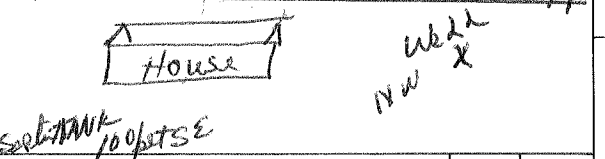

4 Well depth: 30 ft. Date of completion 1-16 76
Well diameter 8 in.

5 ☐ Cable tool ☒ Rotary ☐ Driven ☐ Dug ☐ Hollow rod ☐ Jetted ☐ Bored ☐ Reverse rotary

6 Use: ☒ Domestic ☐ Public supply ☐ Industry ☐ Irrigation ☐ Air conditioning ☐ Commercial ☐ Test well ☐ House Well

7 Casing: Material PVC Height: above/below Above
Threaded ☐ Welded ☐ Surface 24 in.
Diam. 5 in. to 30 ft. depth Weight 160 lbs./ft 100
___ in. to ___ ft. depth Drive shoe? ☐ Yes ☒ No

2 Type and color of material	From	To
Soil	0	1
Clay	1	10
Clay and fine Sand	10	20
Coarse Gravel -	30	
TOTAL depth of well.		
30 feet Red Rock Bottom		

(use a second sheet if needed)

8 ☒ Screen:
Manufacturer Jess x dowell
Type PVC Dia. 5
Slot/gauze 24 Length 20
Set between 10 20 ft. and 30 ft.
Fittings:
Gravel pack ☒ Yes ☐ No Size range of material 1/4

9 Static water level:
22 ft. below land surface Date 1-16 76

10 Pumping level below land surfaces:
___ ft. after ___ hrs. pumping NH g.p.m.
___ ft. after ___ hrs. pumping ___ g.p.m.
Estimated maximum yield ___ g.p.m.

11 Water sample submitted:
☐ Yes ☒ No Date 1-16 76

12 Well head completion:
☐ Pitless adapter ☒ Inches above grade Casing 2x4

13 Well grouted? ☒ Yes ☐ No
☒ Neat cement ☐ Bentonite ☐ ___
Depth: From 1 ft. to 10 ft.

14 Nearest source of possible contamination:
ft. 100 Direction SE Type Septic Tank
Well disinfected upon completion? ☒ Yes ☐ No

15 Pump: ☐ Not installed
Manufacturer's name Burks Jet 1/2 HP
Model number HV30 HP 1/2 Volts 110
Length of drop pipe 28 ft. capacity 15 g.m.p.
Type:
☐ Submersible ☐ Turbine
☒ Jet ☐ Reciprocating
☐ Centrifugal ☐ Other

16 Remarks: elevation

Topography:
☐ Hill
☐ Slope
☒ Upland
☐ Valley

17 Water well contractor's certification:
This well was drilled under my jurisdiction and this report is true to the best of my knowledge and belief.
Wilson Well Service 226
Business name License No.
Address Washington Kansas
Signed Leon A Wilson Date 1-16 76
Authorized representative

Forward the white, blue and pink copies to the Kansas State Dept. Of Health.

Form WWC-5