


Distance and direction from nearest town or city street address of well if located within city?

3 LOCATE WELL'S LOCATION WITH 4 DEPTH OF COMPLETED WELL. 25 ft. ELEVATION:

1	2	
---	---	---	---	---	---	---	---	---	----	----	-----

WELL'S STATIC WATER LEVEL _____ ft. below land surface measured on mo/day/yr

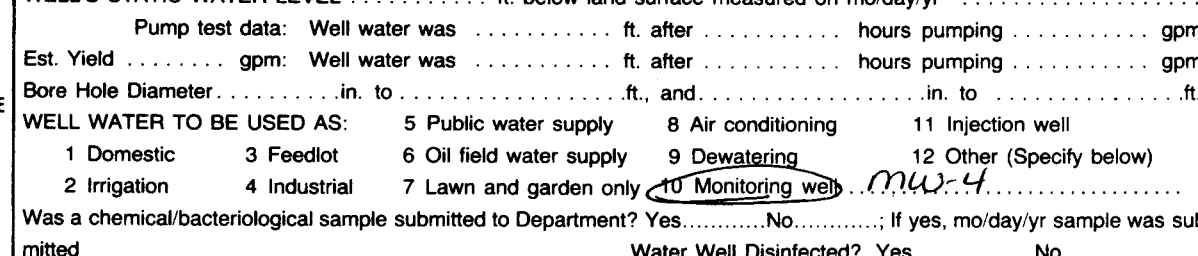

1 Steel	3 BMP (SR)	6 Asbestos-Cement	9 Other (specify below)	Welded
---------	------------	-------------------	-------------------------	--------

Blank casing diameter	in to	# Dia	in to	# Dia	in to	# Dia
	2	13				

TYPE OF SCREEN OR PERFORATION MATERIAL: 1/2" PVC 10. Asbestos cement

1 Steel	3 Stainless steel	5 Fiberglass	8 RMP (SR)	11 Other (specify)
2 Brass	4 Galvanized steel	6 Concrete/tile	9 ABS	12 Not applicable

SCREEN OR PERFORATION OPENINGS ARE: 5 Gauzed wrapped 8 Saw cut 11 None (open hole)

2 Louvered shutter 4 Key punched 7 Torch cut 10 Other (specify)

From ft. to ft., From ft. to ft.

From _____ ft. to _____ ft., From _____ ft. to _____ ft.

Grout Intervals: From 0 ft. to 9 ft., From 9 ft. to 11 ft., From 23 ft. to 25 ft.

1 Septic tank	4 Lateral lines	7 Pit privy	11 Fuel storage	15 Oil well/Gas well
---------------	-----------------	-------------	-----------------	----------------------

3 Watertight sewer lines	6 Seepage pit	9 Feedyard	13 Insecticide storage
--------------------------	---------------	------------	------------------------

FROM	TO	LITHOLOGIC LOG	FROM	TO	PLUGGING INTERVALS
------	----	----------------	------	----	--------------------

7 CONTRACTOR'S OR LANDOWNER'S CERTIFICATION: This water well was (1) constructed (2) reconstructed or (3) plugged under my jurisdiction and was

Water Well Contractor's License No. 551 This Water Well Record was completed on (mo/day/yr) 05/24/04

Associated Environmental Industries Corp. by (signature)