USE TYPEWRITER OR BALL POINT PEN-PRESS FIRMLY, PRINT CLEARLY.

WATER WELL RECORD
KSA 82a-1201-1215

Kansas Department of Health and Environment-Division of Environment
(Water well Contractors)
Topeka, Kansas 66620

1. Location of well:	County: Barber	Fraction: SW 1/4 NW 1/4 NW 1/4	Section number: 32	Township number: T 33 S	Range number: R 12 E (W)

2. Distance and direction from nearest town or city: 9 N of Kans.
Street address of well location if in city: Hardtner, Kans.

3. Owner of well: Robert Watts
R.R. or street:
City, state, zip code: Hardtner, Kans

4. Locate with "X" in section below: Sketch map:

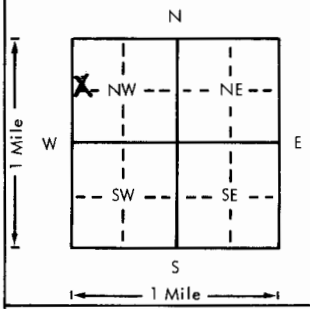

Water used for Grassland.

6. Bore hole dia. 8 in. Completion date 4/4/80
Well depth 75 ft.

7. __ Cable tool X Rotary __ Driven __ Dug
__ Hollow rod __ Jetted __ Bored __ Reverse rotary

8. Use: __ Domestic __ Public supply __ Industry
__ Irrigation __ Air conditioning X Stock
__ Lawn __ Oil field water __ Other

9. Casing: Material pits
Threaded ___ Welded ___
RMP X PVC ___
Dia. 5 in. to 75 ft. depth
Dia. ___ in. to ___ ft. depth
Height: (Above) or below
Surface 12 in.
Weight ___ lbs./ft.
Wall Thickness: inches or gage No. .200

5. Type and color of material	From	To
Topsoil	0	3
Sand + Clay - brown	3	8
Sand + Clay grayish brown	8	20
Clay + Shale - redish	20	50
Shale - red	50	75

(Use a second sheet if needed)

10. Screen: Manufacturer's name J+L
Type RMP Dia. 5 in.
(Slot) gauze 1/16 Length 20
Set between 50 ft. and 70 ft.
___ ft. and ___ ft.
Gravel pack? yes Size range of material 1/4 - 1/8

11. Static water level: mo./day/yr.
20 ft. below land surface Date ___

12. Pumping level below land surfaces:
___ ft. after ___ hrs. pumping ___ g.p.m.
___ ft. after ___ hrs. pumping ___ g.p.m.
Estimated maximum yield 20 g.p.m.

13. Water sample submitted: mo./day/yr.
__ Yes X No Date ___

14. Well head completion:
X Pitless adapter 12 Inches above grade

15. Well grouted? yes
With: ___ Neat cement X Bentonite ___ Concrete
Depth: From 0 ft. to 10 ft.

16. Nearest source of possible contamination: None
ft. ___ Direction ___ Type ___
Well disinfected upon completion? ___ Yes X No

17. Pump: ___ Not installed
Manufacturer's name Webtrol
Model number ___ HP 1 1/2 Volts 220
Length of drop pipe 60 ft. capacity 20 g.p.m.
Type:
X Submersible ___ Turbine
___ Jet ___ Reciprocating
___ Centrifugal ___ Other

18. Elevation:
Topography:
___ Hill
X Slope
___ Upland
___ Valley

19. Remarks:

20. Water well contractor's certification:
This well was drilled under my jurisdiction and this report is true to the best of my knowledge and belief.
Business name Lehl + Son Waterwell Drlg. License No. 141
Address 132 E 9th Alva, OK
Signed Carl Lehl Date 4/29/80
Authorized representative

T 33 R 12 E (W) Sec 32 1/4 SW 1/4 NW 1/4 NW 1/4

Forward the white, blue and pink copies to the Department of Health and Environment

Form WWC-5

MI-1023