

1 LOCATION OF WATER WELL:	Fraction	Section Number	Township Number	Range Number
County: Barber	SE 1/4 SW 1/4 SW 1/4	15	T 33 S	R 15 W E/W

Distance and direction from nearest town or city street address of well if located within city?

5½ N 1 E Aetna


2 WATER WELL OWNER: B & F Cattle Co.
RR#, St. Address, Box #: Box 841
City, State, ZIP Code: Alva, Okla. 73717

Board of Agriculture, Division of Water Resources

Application Number:

3] LOCATE WELL'S LOCATION WITH AN "X" IN SECTION BOX:

4 DEPTH OF COMPLETED WELL. 106 ft. ELEVATION:

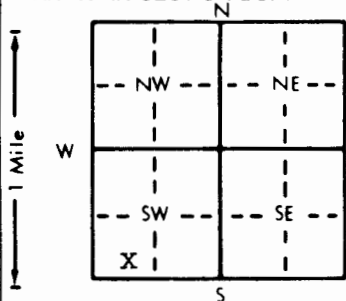

Depth(s) Groundwater Encountered 1. ft. 2. ft. 3. ft.

WELL'S STATIC WATER LEVEL ... 20 ... ft. below land surface measured on mo/day/yr 10-27-94

Pump test data: Well water was ft. after hours pumping gpm

Est. Yield gpm: Well water was ft. after hours pumping gpm

Bore Hole Diameter . . . 9 . . . in. to . . . 106 . . . ft. and . . . in. to . . . ft.

WELL WATER TO BE USED AS:	5 Public water supply	8 Air conditioning	11 Injection well
---------------------------	-----------------------	--------------------	-------------------

1 Domestic	3 Feedlot	6 Oil field water supply	9 Dewatering	12 Other (Specify below)
------------	-----------	--------------------------	--------------	--------------------------

2 Irrigation 4 Industrial 7 Lawn and garden only 10 Monitoring well

Was a chemical/bacteriological sample submitted to Department? Yes.....No.....; If yes, mo/day/yr sample was sub-

Water Well Disinfected? Yes No

5	TYPE OF BLANK CASING USED:
---	----------------------------

1 Steel 3 RMP (SR) 6 Asbestos-Cement 9 Other (specify below) Welded

2. PVC 4 ABS 7 Fiberglass Threaded.....

ank casing diameter 5 in. to 23 ft. Dia. in. to ft. Dia. in. to ft.

Casing height above land surface... 16 ... in., weight ... lbs./ft. Wall thickness or gauge No. 210

TYPE OF SCREEN OR PERFORATION MATERIAL:	7 PVC	10 Asbestos-cement
---	-------	--------------------

1 Steel 3 Stainless steel 5 Fiberglass 8 RMP (SR) 11 Other (specify)

2 Brass	4 Galvanized steel	6 Concrete tile	9 ABS	12 None used (open hole)
---------	--------------------	-----------------	-------	--------------------------

GREEN OR PERFORATION OPENINGS ARE: 5 Gauzed wrapped 8 Saw cut 11 None (open hole)

1 Continuous slot 3 Mill slot 6 Wire wrapped 9 Drilled holes

2 Louvered shutter	4 Key punched	7 Torch cut	10 Other (specify)
--------------------	---------------	-------------	------------------------------

REIN-FORCED INTERVALS: From 23 ft. to 106 ft. From ft. to ft.

From ft. to ft. From ft. to ft.

From 23 ft. to 106 ft. From _____ ft. to _____ ft.

From	ft. to	ft., From	ft. to	ft.

ment 2 Cement grout 3 Bentonite 4 Other

Grout Intervals: From 3 ft. to 23 ft. From _____ ft. to _____ ft. From _____ ft. to _____ ft.

What is the nearest source of possible contamination: 10 Livestock pens 14 Abandoned water well

1 Septic tank 4 Lateral lines 7 Pit privy 11 Fuel storage 15 Oil well/Gas well

2 Sewer lines 5 Cess pool 8 Sewage lagoon 12 Fertilizer storage 16 Other (specify below)

3 Watertight sewer lines	6 Seepage pit	9 Feedyard	13 Insecticide storage	

Direction from well West. How many feet? 300

TO	PI
----	----

3	3	soil
3	5	clay
5	9	sand
9	15	soft shale
15	106	red shale

7. CONTRACTOR'S OR LANDOWNER'S CERTIFICATION: This water well was (1) constructed (2) reconstructed or (3) plugged under my jurisdiction and was

completed on (mo/day/year) 10-14-94 and this record is true to the best of my knowledge and belief. Kansas

Water Well Contractor's License No. 140 This Water Well Record was completed on (mo/day/yr) 11-12-94

under the business name of Lyman Inc. by (signature) [Signature]

INSTRUCTIONS: Use typewriter or ball point pen. PLEASE PRESS FIRMLY and PRINT clearly. Please fill in blanks, underline or circle the correct answers. Send top three copies to Kansas Department

INSTRUCTIONS: Use typewriter or ball point pen. PLEASE PRESS HARD and PRINT clearly. Please fill in blanks, underline or circle the correct answers. Send top three copies to Kansas Department of Health and Environment, Bureau of Water, Topeka, Kansas 66620-0001. Telephone: 913-296-5545. Send one to WATER WELL OWNER and retain one for your records.